

MICHIGAN
DEPARTMENT OF CONSERVATION
FORESTRY DIVISION

LAND CORNER RECORD

T. 46 N.R. 16 W.


Schoolcraft COUNTY

DESCRIPTION OF CORNER 1/4 corner for Sections 20 and 29.

CORNER MONUMENT 1" Iron Pipe with 4" Aluminum Cap.

DATE MONUMENT PLACED AND WITNESSED 6/20/63

WITNESSES TO CORNER..... 10" Y. Pipe (1/4 S.) (N.B.T.), N. 89° E., 567 Lks.

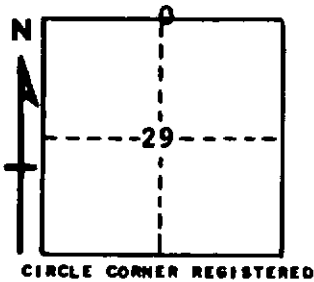

AND

DESCRIPTION IN DETAIL AS TO HOW CORNER WAS LOCATED AND IDENTIFIED OR RESTORED.

This corner was placed by single proportionate distance and on line between section corners.

SURVEYOR'S SEAL

SIGNED Billy D. Buckler DATE 7-26-63
REGISTERED LAND SURVEYOR
Billy D. Buckler