

MICHIGAN
DEPARTMENT OF CONSERVATION
FORESTRY DIVISION

LAND CORNER RECORD

T. 47.. NR. 13 W..

Schoolcraft

COUNTY

DESCRIPTION OF CORNER 1/4 Corner between Sections 31 and 32

DESCRIPTION OF CORNER MONUMENT 1" pipe with 4" brass cap

WITNESSES TO CORNER 12" Red Pine N 80° W 145 links

DESCRIPTION IN DETAIL AS TO HOW CORNER WAS LOCATED AND IDENTIFIED OR RESTORED.


Corner established by Survey Crew, on line, midway between corners.

No original evidence.

Corner placed 37 links West and 1 link North of 40.08 ch. from North.

Corner placed and witnessed June 24, 1955.

SURVEYORS SEAL

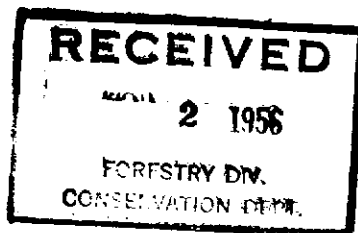

SIGNED

Billy D. Buckley
REGISTERED LAND SURVEYOR

DATE 2/28/56