

MICHIGAN  
DEPARTMENT OF CONSERVATION  
FORESTRY DIVISION

LAND CORNER RECORD

T. 47.. NR. 13 & 14 W

----- Schoolcraft ----- COUNTY

DESCRIPTION OF CORNER 1/4 Corner between Sections 31 and 36 -----

DESCRIPTION OF CORNER MONUMENT 1" pipe with 4" brass cap -----

WITNESSES TO CORNER 36" W. Pine Stump S 82° E 58 links -----


36" W. Pine Stump S 23° W 135 links -----

DESCRIPTION IN DETAIL AS TO HOW CORNER WAS LOCATED AND IDENTIFIED OR RESTORED.

Section Corner established by Survey Crew, in line midway between Sections Corners.

Corner placed 16 links South and 7 links West of 40.00 ch. from North.

Corner placed and witnessed June 24, 1955.

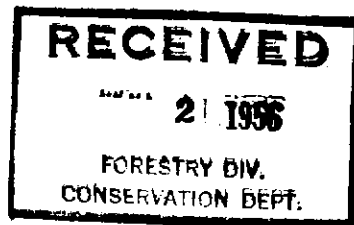

SURVEYORS SEAL

SIGNED

*Billy D. Buckles*  
REGISTERED LAND SURVEYOR

DATE 2/28/56