

MICHIGAN  
DEPARTMENT OF CONSERVATION  
FORESTRY DIVISION



# LAND CORNER RECORD

T. 47N N.R. 13W


Schoolcraft COUNTY

DESCRIPTION OF CORNER Sec. Cor. common to Secs. 8-9-16-17

CORNER MONUMENT 1" pipe with 4" aluminum cap.

DATE MONUMENT PLACED AND WITNESSED 9-17-70

WITNESSES TO CORNER..... 14" W. Pine (S16 NBT) S7°E 24.2'

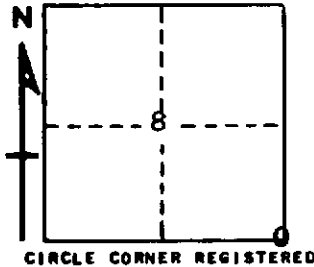

12" Soft Maple (S9 NBT) N40°E 25.5'

AND

**DESCRIPTION IN DETAIL AS TO HOW CORNER WAS LOCATED AND IDENTIFIED OR RESTORED.**

This corner replaced at an old wood post. Found remains of a W. Pine B.T.; a stump, bearing N74°W, 23 links.

Also found a green cedar, now 28" in diameter, bearing N64°E, 33 links. This tree has an upper face with scribe marks "S 9", no lower blaze evident. This appears to be old enough for an unrecorded witness, marked at the time of the original survey.

SURVEYOR'S SEAL

SIGNED Billy D. Buckler DATE 10-15-70  
REGISTERED LAND SURVEYOR