

MICHIGAN
DEPARTMENT OF CONSERVATION
FORESTRY DIVISION

LAND CORNER RECORD

T. 47 N.R. 15W

Schoolcraft COUNTY


DESCRIPTION OF CORNER Center Corner of Section 22.

CORNER MONUMENT 1" Iron Drill Rod.

DATE MONUMENT PLACED AND WITNESSED 4-22-63.

WITNESSES TO CORNER..... 8" W. Pine N. 70° E., 08½ lks.

4" W. Pine S. 29° E., 28½ lks.

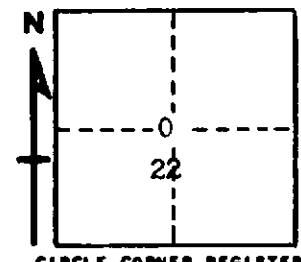

AND

CIRCLE CORNER REGISTERED

DESCRIPTION IN DETAIL AS TO HOW CORNER WAS LOCATED AND IDENTIFIED OR RESTORED.

This corner was placed by R. J. Brotherton, Registered Land Surveyor.
Corner lies 52 links East of Road.

SURVEYOR'S SEAL

SIGNED Billy D. Buckler DATE 4/2/64
REGISTERED LAND SURVEYOR