

**SURVEY & REMONUMENTATION**

DEC 15 1993

COMMISSION

**LAND CORNER RECORDATION CERTIFICATE**  
**Filing Requirement of Act 74, Mich. P.A. 1970**

RECORDED  
 93 DEC -6 AM 10:59

For corners in

Shiawassee (County) Located In: Corner Code #/

1. Public Land Survey T 5N R 1E K-11  
 T R  
 T R  
 T R

2. Property Controlling S T R  
 in Section S T R


3. Miscellaneous S T R  
 Property in Sec. S T R

4. Lot No. , Recorded Plat

5. Private Claims

REGISTER OF DEEDS  
*Agnes [Signature]*  
 SHIawassee COUNTY, MICH.

Register of Deeds Stamp & File Number

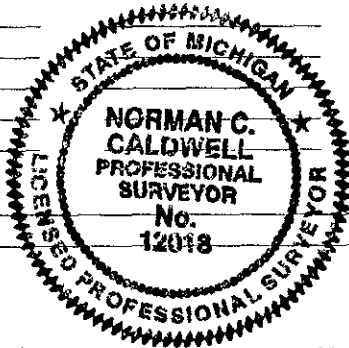

	A	B	C	D	E	F	G	H	I	J	K	L	M
2	6		5		4		3		2		1		
3													
4	7		8		9		10		11		12		
5													
6	18		17		16		15		14		13		
7													
8	19		20		21		22		23		24		
9													
10	30		29		28		27		26		25		
11													
12	31		32		33		34		35		36		
13													

Norman C. Caldwell, in a field survey on November, 1993, do hereby certify that under requirements of P.A. 74, Michigan P.A. of 1970, the corner points mentioned in lines 1 and 2 above were in conformance with regulations and rules therefore as required in the current manual of survey instructions of the United States Department of the Interior, Bureau of Land Management or by a decree of a Court of Law and/or that the corner points mentioned in lines 3, 4 and 5 above were in conformance with the rules of the Michigan Board of Land Surveyors or by a Decree of a Court of Law; established, re-established, monumented, re-monumented, recovered, found as expressed below:

**NOTE: Not more than 4 corners, all in the same town and range, may be recorded on this certificate.**

**A. Description of original monument and accessories and/or subsequent restoration:**

<-11 Sec. cor., 25, 26, 35 & 36, T5N-R1E

Wood post placed by J. Wampler, 1826  
 N85 1/2°E 4.5 lks. (2.97') 14" Birch  
 S68 1/2°W 33 lks. (21.78') 18" Birch

Survey by H. C. Main, Co. Surveyor, Oct. 1887, recorded in Book D/E pgs. 170 & 171  
 S50 1/2°E 94 lks. (62.04') 36" Elm

Survey by O. M. Elliot, Co. Surveyor, 1957, recorded in Book 28, pg. 45  
 Monument not given  
 S60°W 60.4' 18" Hickory  
 N45°W 36.8' Road sign  
 N15°E 69.5' 36" Oak

Survey by F. White, Nov. 1972 recorded in L. 1, pg. 93 of Corners & L. 1, pgs. 375 & 376 of Surveys.  
 Set 1/2" iron by proportional measurement  
 N45°W 36.10' Street sign  
 S65°W 58.90' N & T Hickory  
 N60°E 65.90' N & T Power Pole

Survey by R. M. Lester, Dec. 1973 recorded in L. 1, pg. 172 of Corners & L. 1, pgs. 578 & 579 of Surveys  
 Fnd. R.R. Spike  
 NNE 69.75' N & T W. side 48" Oak  
 NE 47.20' N & T W. side 10" Oak  
 SW 58.11' N & T N. side 20" Hickory

Survey by J. F. Quine, Co. Surveyor, March 1975 recorded in L. 1, pg. 557 of Corners

Fnd. 1" iron shaft stake flush w/sealcoat pavement  
 NW 36.9' Road name sign post  
 NE 69.0' 36" Oak  
 E-NE 64.0' Tele. Pole  
 SE 34.7' Wooden fence post  
 SW 89.1' NE cor. barn foundation  
 SW 60.4' 20" Hickory

Survey by L. A. Bryan, Oct. 1984 & Dec. 1987 recorded in L. 4, pgs. 307 - 309 & L. 5, pgs. 562 & 563 of Surveys

Survey by K. Shellenbarger, May 1993, June 1993, recorded in L. 2, pg. 856 (corners) & L. 6, pg. 488 (surveys).

**B. Description of corner evidence found and/or method applied in restoring or reestablishing corner:**

=-11 Sec. cor., 25, 26, 35 & 36, T5N-R1E

Fnd. R.R. spike per L. 1, pg. 93 & 172, L. 2, pg. 856 of Corners, L. 1, pgs. 375, 578, L. 4, pg. 307, L. 5, pg. 562, & L. 6, pgs. 488 of Surveys. Also found 1" iron shaft per Elliot and Quine's records. The Shiawassee County Peer Review Group recommended holding R.R. Spike due to the vast amount of survey work and corners that were established using this position. Replaced R.R. Spike with standard 20" Harrison marker per Shiawassee County Peer Review Group recommendation, also placed a monument box, and is accepted as the best available evidence of the position of the original corner.

**C. Description of monument for corner and accessories established to perpetuate locating the position of the corner:**

=-11 Sec. cor., 25, 26, 35 & 36, T5N-R1E

Fnd. R.R. Spike, replaced with a standard 20" Harrison monument as approved by the Shiawassee County Peer Review Group and is accepted as the best available evidence of the position of the original corner.

N45°W 36.67' Street sign (R)  
 N30°E 69.62' Fnd. N & T W. face 42" Oak (R)  
 N55°E 65.94' Fnd. N & T #12034 NW face Power Pole (R)  
 S30°W 62.83' Fnd. N & T SE face Twin 12" Hickory (R)  
 N86°E 1.79' 1/2" bar with #12018 cap over 1" bar (Elliot & Quine)

PLACED MONUMENT BOX

signed by *Norman C. Caldwell* Date 20 NOV 93

Surveyor's Michigan License No. 12018