

SURVEY & REMONUMENTATION COMMISSION

DEC 15 1993

LAND CORNER RECORDATION CERTIFICATE
Filing Requirement of Act 74, Mich. P.A. 1970
REMONUMENTATION

RECORDED

93 DEC -6 AM 10:59

REGISTER OF DEEDS

Shirley A. ...
 SHIawassee COUNTY, MICH.

For corners in Shiawassee (County) Located in: Corner Code #/

1. Public Land Survey	T 5N R 1E	M-13
	T _____ R _____	_____
	T _____ R _____	_____
	T _____ R _____	_____
2. Property Controlling in Section	S _____ T _____ R _____	_____
	S _____ T _____ R _____	_____
3. Miscellaneous Property in Sec.	S _____ T _____ R _____	_____
	S _____ T _____ R _____	_____

Register of Deeds Stamp & File Number

4. Lot No. _____, Recorded Plat _____
 5. Private Claims _____

	A	B	C	D	E	F	G	H	I	J	K	L	M
2	6	5	4	3	2	1							
3													
4	7	8	9	10	11	12							
5													
6	18	17	16	15	14	13							
7													
8	19	20	21	22	23	24							
9													
10	30	29	28	27	26	25							
11													
12	31	32	33	34	35	36							
13													

Norman C. Caldwell, in a field survey on November, 1993, do hereby certify that under requirements of P.A. 74, Michigan P.A. of 1970, the corner points mentioned in lines 1 and 2 above were in conformance with regulations and rules therefore as required in the current manual of survey instructions of the United States Department of the Interior, Bureau of Land Management or by a decree of a Court of Law and/or that the corner points mentioned in lines 3, 4 and 5 above were in conformance with the rules of the Michigan Board of Land Surveyors or by a Decree of a Court of Law; established, re-established, monumented, re-monumented, recovered, found as expressed below:

NOTE: Not more than 4 corners, all in the same town and range, may be recorded on this certificate.

A. Description of original monument and accessories and/or subsequent restoration:

-13 Twp. cor., common to T4 & 5N - R1 & 2E

Wood post placed by J. Wampler, 1826
 S15°E 21 lks. (13.86') 10" Tamarack
 N10°W 27 lks. (17.82') 12" Tamarack

Surveys by M. L. Vanraendonck, 1984 & 1992 recorded in L. 2, pg. 380 of Corners & L. 4, pg. 119 & L. 6, pg. 178 of Surveys
 Fnd. rered and cap #18989
 North 10.00' Nail 12" wood post
 S05°W 32.90' N & W 10" Elm
 S45°E 57.00' Nail 10" Ash
 N85°E 85.24' N & W 24" Maple

B. Description of corner evidence found and/or method applied in restoring or reestablishing corner:

-13 Twp. cor., common to T4 & 5N - R1 & 2E

Fnd. 1/2" rered w/cap #25832 per L. 2, pg. 380 of Corners and L. 4, pg. 119 & L. 6, pg. 178 of Surveys, fits reasonably well with GLO swamp calls. Replaced with a standard 20" Harrison marker as approved by Shiawassee County Peer Review Group and is accepted as the best available evidence of the position of the original corner.


NOTE: In excavation for the placement of the monument, we found a 4" dia. conc. mon. at the corner position.
 (ORIGIN UNKNOWN)

C. Description of monument for corner and accessories established to perpetuate locating the position of the corner:

-13 Twp. cor., common to T4 & 5N - R1 & 2E

Fnd. 1/2" rered w/cap #25832 per L. 2, pg. 380 of Corners and L. 4, pg. 119 & L. 6, pg. 178 of Surveys, fits reasonably well with GLO swamp calls. Replaced with a standard 20" Harrison marker as approved by Shiawassee County Peer Review Group and is accepted as the best available evidence of the position of the original corner.

North 9.79' Fnd. Nail E. face 12" Wood post (R)
 S05°W 32.98' Fnd. N & W NE face dead 10" Elm (R)
 S45°E 57.15' Fnd. Nail NE 10" Ash (R)
 N85°E 85.87' Fnd. N & W NE 24" Maple (R)
 South 33.30' Fnd. 1/2" iron w/cap #25832

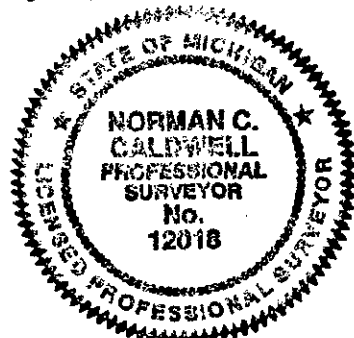

Signed by Norman C. Caldwell Date 20 Nov 93
 Surveyor's Michigan License No. 12018