

**SURVEY & REMONUMENTATION**

DEC 15 1993

**COMMISSION**

**LAND CORNER RECORDATION CERTIFICATE**  
**Filing Requirement of Act 74, Mich. P.A. 1970**  
**REMONUMENTATION**

RECORDED

93 DEC -6 AM 10:59

REGISTER OF DEEDS  
*Shirley J. ...*  
 SHIAWASSEE COUNTY, MICH.

For corners in

Shiawassee (County)	Located In:	Corner Code =#
1. Public Land Survey	T 5N R 2E	K-11
	T _____ R _____	_____
	T _____ R _____	_____
	T _____ R _____	_____
2. Property Controlling in Section	S _____ T _____ R _____	_____
	S _____ T _____ R _____	_____
3. Miscellaneous Property in Sec.	S _____ T _____ R _____	_____
	S _____ T _____ R _____	_____

Register of Deeds Stamp & File Number

4. Lot No. \_\_\_\_\_, Recorded Plat \_\_\_\_\_  
 5. Private Claims \_\_\_\_\_

	A	B	C	D	E	F	G	H	I	J	K	L	M
2	6		5		4		3		2		1		
3													
4	7		8		9		10		11		12		
5													
6	18		17		16		15		14		13		
7													
8	19		20		21		22		23		24		
9													
10	30		29		28		27		26		25		
11													
12	31		32		33		34		35		36		
13													

Norman C. Caldwell, in a field survey on November, 19 93, do hereby certify that under requirements of P.A. 74, Michigan P.A. of 1970, the corner points mentioned in lines 1 and 2 above were in conformance with regulations and rules therefore as required in the current manual of survey instructions of the United States Department of the Interior, Bureau of Land Management or by a decree of a Court of Law and/or that the corner points mentioned in lines 3, 4 and 5 above were in conformance with the rules of the Michigan Board of Land Surveyors or by a Decree of a Court of Law; established, re-established, monumented, re-monumented, recovered, found as expressed below:

**NOTE: Not more than 4 corners, all in the same town and range, may be recorded on this certificate.**

**A. Description of original monument and accessories and/or subsequent restoration:**

K-11 Sec. cor., 25, 26, 35 & 36, T5N-R2E

Wood post placed by J. Wampler, 1826  
 S25°W 14 lks. (9.24') 12' Ash  
 S86°E 8 1/2 lks. (5.61') 38" Ash

Survey by O. M. Elliot, date unknown,  
 CR-38, pg. 51,  
 Mon. not given

Unrecorded survey by Odd Johnsrud, P.E., R.L.S. #18434.  
 Placed 1/2" bar w/#11192 cap in CL E-W road and in line  
 w/fence South (Job #0193, June 11, 1976)  
 N60°W 46.10' Tele. pole  
 S60°E 35.73' 6" Tree  
 S30°W 28.09' S. end top 24" CMP

Surveys by M. L. Vanraemdonck, recorded in Surveys  
 L. 4, pg. 479, (1986), L. 4, pg. 655, (1987) & L. 5,  
 pg.s 931 & 932 (1991)  
 Fnd. rerod w/cap, couldn't read  
 N35°W 38.70' Top center N end 24" CMP  
 S30°W 18.40' PK in N face W trunk Twin 5" Elm  
 S45°W 28.75' Top center S end 24" CMP (R)  
 S10°W 15.50' W edge W leg arrow sign

**B. Description of corner evidence found and/or method applied in restoring or reestablishing corner:**


K-11 Sec. cor., 25, 26, 35 & 36, T5N-R2E

Fnd. 1/2" rerod w/unreadable cap per record and unrecorded surveys  
 L. 4, pg.s 479 & 655 & L. 5, pgs. 931 & 932. Replaced with a standard  
 20" Harrison marker as approved by Shiawassee County Peer Review Group  
 and is accepted as the best available evidence of the position of the  
 original corner.

**C. Description of monument for corner and accessories established to perpetuate locating the position of the corner:**

K-11 Sec. cor., 25, 26, 35 & 36, T5N-R2E

Fnd. 1/2" rerod w/unreadable cap per record and unrecorded surveys  
 L. 4, pg.s 479 & 655 & L. 5, pgs. 931 & 932. Replaced with a standard  
 20" Harrison marker as approved by Shiawassee County Peer Review Group  
 and is accepted as the best available evidence of the position of the  
 original corner.  
 S10°W 16.32' W. leg traffic arrow sign  
 S45°W 28.84' Top center S end 24" CMP (R)  
 N35°W 38.58' Top center N end 24' CMP (R)  
 S30°E 35.45' Fnd. PK N face E trunk Twin 8" Elm (R)

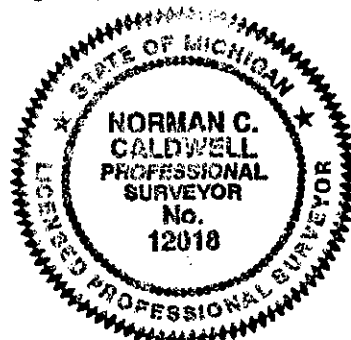

Signed by *Norman C. Caldwell* Date 20 NOV 93  
 Surveyor's Michigan License No. 12018