

**SURVEY &
REMONUMENTATION**

DEC 15 1993

LAND CORNER RECORDATION CERTIFICATE
Filing Requirement of Act 74, Mich. P.A. 1970
REMONUMENTATION

RECORDED

93 DEC -6 AM 10:58

COMMISSION

For corners in _____
_____ (County) Located In: _____ Corner Code ~~##~~

1. Public Land Survey	T <u>5</u> N	R <u>3</u> E	<u>K-11</u>
	T _____	R _____	_____
	T _____	R _____	_____
	T _____	R _____	_____
2. Property Controlling in Section	S _____	T _____	R _____
	S _____	T _____	R _____
3. Miscellaneous Property in Sec.	S _____	T _____	R _____
	S _____	T _____	R _____

REGISTER OF DEEDS
Steph...

Register of Deeds Stamp & File Number

Lot No. _____, Recorded Plat _____
Private Claims _____

A	B	C	D	E	F	G	H	I	J	K	L	M
2	6	5	4	3	2	1						
3												
4	7	8	9	10	11	12						
5												
6	18	17	16	15	14	13						
7												
8	19	20	21	22	23	24						
9												
10	30	29	28	27	26	25						
11												
12	31	32	33	34	35	36						
13												

Norman C. Caldwell, in a field survey on November, 19 93, do hereby certify that under requirements of P.A. 74, Michigan P.A. of 1970, the corner points mentioned in lines 1 and 2 above were in conformance with regulations and rules therefore as required in the current manual of survey instructions of the United States Department of the Interior, Bureau of Land Management or by a decree of a Court of Law and/or that the corner points mentioned in lines 3, 4 and 5 above were in conformance with the rules of the Michigan Board of Land Surveyors or by a Decree of a Court of Law; established, re-established, monumented, re-monumented, recovered, found as expressed below:

NOTE: Not more than 4 corners, all in the same town and range, may be recorded on this certificate.

A. Description of original monument and accessories and/or subsequent restoration:

-11 Sec. cor., 25, 26, 35 & 36, T5N-R3E

Wood post placed by J. Mullett, 1823
S07°W 86 lks. (56.76') 15" Elm
S82°E 19 lks. (12.54') 12" Poplar

L.C.R.C. by K. R. Piotrowski, June 1972,
recorded in Corners L. 1, pg. 140,
Fnd. 3/4" steel rod
N75°W 23.17' NE cor. headwall
N45°E 15.44' Road sign
S60°E 51.85' Tele. Pole
S60°W 33.35' SE cor. headwall


Survey by A. F. Miller, July 1972,
recorded in Surveys L. 1, pg. 112
Fnd. 3/4" steel rod
Same references as L. 1 pg. 140 above

Survey by K.R. Piotrowski, March 1974,
recorded in Surveys L. 1, pg. 612
Fnd. 3/4" steel rod
Same references as L. 1, pg. 140 above

Survey by A. F. Miller, Dec. 1977, recorded
in Surveys, L. 2, pg. 620
Fnd. 3/4" steel rod
N75°W 23.17' NE cor. headwall
N45°E 15.44' Road sign
S60°E 51.85' Tele. Pole
S60°W 33.35' SE cor. headwall

Survey by M. L. Vanraemdonck, 1986, recorded
in L. 4, pg. 473
Fnd. rerod
N10°W 26.00' PK E. face 6" Elm
N45°E 18.20' S. face traffic sign post
S45°E 52.00' PK N. face Tele. Pole
S40°W 53.5' S. end 60" CMP

Survey by M. L. Vanraemdonck, 1991, recorded
in Surveys L. 5, pg. 937
Fnd. rerod
Same references as L. 4, pg. 473 above

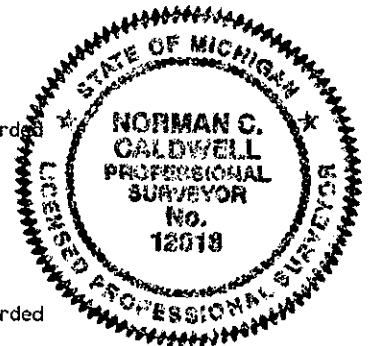

. Description of corner evidence found and/or method applied in restoring or reestablishing corner:

-11 Sec. cor., 25, 26, 35 & 36, T5N-R3E

Dug a 8'x10'x3' deep hole (6" below orig. grnd), at a position at the intersec. determined by the ext. of a line from 1/4 25/36 and 36 thru W 1/16 25 & 36 with a line extended from SW Cor. 36 thru 1/4 35/36. Fnd. 2 blue stones (6"x8"x14") w/wood pst. (upright) btw. them, 12" below wood corduroy. Held this position as the cor. and placed a std. 20" Harrison marker as approved by the Shia. Co. Peer Review Group and is accepted as the best available evidence of the post. of the orig. cor.

. Description of monument for corner and accessories established to perpetuate locating the position of the corner:

-11 Sec. cor., 25, 26, 35 & 36 T5N-R3E

Dug a 8'x10'x3' deep hole (6" below orig. grnd), at a position at the intersec. determined by the ext. of a line from 1/4 25/36 and ~~36~~ thru W 1/16 25 & 36 with a line extended from SW Cor. 36 thru 1/4 35/36. Fnd. 2 blue stones (6"x8"x14") w/wood pst. (upright) btw. them, 12" below wood corduroy. Held this position as the cor. and placed a std. 20" Harrison marker as approved by the Shia. Co. Peer Review Group and is accepted as the best available evidence of the post. of the orig. cor.
N30°W 39.43' Set spike & tag #12018 E. face 10" Elm
S70°W 85.54' Set PK & Tag #12018 N. face tele. pole
S30°E 38.02' Set PK & Tag #12018 NE face tele. pole
N05°E 21.55' W. edge W. leg traffic sign (<->)
N57°W 14.81' Fnd. 3/4" steel rod WHICH WAS ESTABLISHED USING IMPROPER PROCEDURES AND IS UTILIZED FOR RECORD SURVEYS SHOWN ABOVE IN PART "A"

Signed by Norman C. Caldwell Date 20 NOV 93
Surveyor's Michigan License No. 12018