

SURVEY & REMONUMENTATION

DEC 1 1993

LAND CORNER RECORDATION CERTIFICATE

Filing Requirement of Act 74, Mich. P.A. 1970

RECORDED

DEC -6 AM 10:58

For corners in

REMONUMENTATION

Shiawassee (County)	Located In:	Corner Code #
1. Public Land Survey	T 5N R 3E	M-11
	T R	
	T R	
	T R	
2. Property Controlling in Section	S T R	
	S T R	
3. Miscellaneous Property in Sec.	S T R	
	S T R	

REGISTER OF DEEDS
Wayne Shuster
SHIAWASSEE COUNTY, MICH.

Register of Deeds Stamp & File Number

- 4. Lot No. _____, Recorded Plat _____
- 5. Private Claims _____

	A	B	C	D	E	F	G	H	I	J	K	L	M
2	6	5	4	3	2								
3													
4	7	8	9	10	11	12							
5													
6	18	17	16	15	14	13							
7													
8	19	20	21	22	23	24							
9													
10	30	29	28	27	26	25							
11													
12	31	32	33	34	35	36							
13													

I, Norman C. Caldwell, in a field survey on November, 19 93, do hereby certify that under requirements of P.A. 74, Michigan P.A. of 1970, the corner points mentioned in lines 1 and 2 above were in conformance with regulations and rules therefore as required in the current manual of survey instructions of the United States Department of the Interior, Bureau of Land Management or by a decree of a Court of Law and/or that the corner points mentioned in lines 3, 4 and 5 above were in conformance with the rules of the Michigan Board of Land Surveyors or by a Decree of a Court of Law; established, re-established, monumented, re-monumented, recovered, found as expressed below:

NOTE: Not more than 4 corners, all in the same town and range, may be recorded on this certificate.

A. Description of original monument and accessories and/or subsequent restoration:

M-11 Sec. cor., 25 & 36, T5N-R3E
Wood post placed by J. Mullett, 1823,
S01°W 32 lks. (21.12') 9" B. Ash
N43°W 32 lks. (21.12') 10" Birch


Survey recorded in Surveys L. 4, pg. 359 & 360
1985, indicates position of 1/2" bar for
std. & closing corners.

B. Description of corner evidence found and/or method applied in restoring or reestablishing corner:

M-11 Sec. cor., 25 & 36, T5N-R3E
Fnd. 1/2" rebar (origin unknown) per L. 4, pg. 359 & 360.
Replaced with a standard 20" Harrison marker as approved
by the Shiawassee County Peer Review Group and is
accepted as the best available evidence of the position
of the original corner.

C. Description of monument for corner and accessories established to perpetuate locating the position of the corner:

M-11 Sec. cor., 25 & 36, T5N-R3E
Fnd. 1/2" rebar (origin unknown) per L. 4, pg. 359 & 360.
Replaced with a standard 20" Harrison marker as approved
by the Shiawassee County Peer Review Group and is
accepted as the best available evidence of the position
of the original corner.
North 9.41' Fnd. 1/2" bar w/landmark cap at SW cor., Sec. 30, T5N-R4E (R)
North 33.35' Set spike & tag #12018 in W. face Power Pole
N25°W 86.66' SW cor. barn foundation at house #5885
S30°W 16.80' Set spike & tag #12018 in W. face 10" Maple

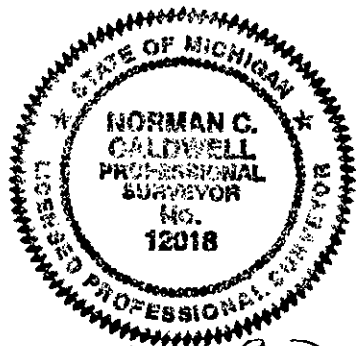

Signed by *Norman C. Caldwell* Date 20 NOV 93
Surveyor's Michigan License No. 12018