

SURVEY & REMONUMENTATION

DEC 15 1993

LAND CORNER RECORDATION CERTIFICATE

RECORDED

Filing Requirement of Act 74, Mich. P.A. 1970

93 DEC -6 AM 10:58

For corners in

REMONUMENTATION

Shiawassee <small>(County)</small>	Located In:	Corner Code #	
1. Public Land Survey	T <u>5N</u> R <u>3E</u>	M-12	_____
	T _____ R _____	_____	_____
	T _____ R _____	_____	_____
	T _____ R _____	_____	_____
2. Property Controlling in Section	S _____ T _____ R _____	_____	_____
	S _____ T _____ R _____	_____	_____
3. Miscellaneous Property in Sec.	S _____ T _____ R _____	_____	_____
	S _____ T _____ R _____	_____	_____

REGISTER OF DEEDS
Spencer Shultz
SHIawassee COUNTY, MICH.

Register of Deeds Stamp & File Number

4. Lot No. _____, Recorded Plat _____
5. Private Claims _____

	A	B	C	D	E	F	G	H	I	J	K	L	M
2	6		5		4		3		2		1		
3													
4	7		8		9		10		11		12		
5													
6	18		17		16		15		14		13		
7													
8	19		20		21		22		23		24		
9													
10	30		29		28		27		26		25		
11													
12	31		32		33		34		35		36		
13													

I, Norman C. Caldwell, in a field survey on November, 19 93,

do hereby certify that under requirements of P.A. 74, Michigan P.A. of 1970, the corner points mentioned in lines 1 and 2 above were in conformance with regulations and rules therefore as required in the current manual of survey instructions of the United States Department of the Interior, Bureau of Land Management or by a decree of a Court of Law and/or that the corner points mentioned in lines 3, 4 and 5 above were in conformance with the rules of the Michigan Board of Land Surveyors or by a Decree of a Court of Law; established, re-established, monumented, re-monumented, recovered, found as expressed below:

NOTE: Not more than 4 corners, all in the same town and range, may be recorded on this certificate.

A. Description of original monument and accessories and/or subsequent restoration:

M-12 E 1/4 cor., Sec. 36, T5N-R3E
Wood post placed by J. Mullett, 1823,
N06°W 26 lks. (17.16') 8" B. Oak
S49°W 55 lks. (36.30') 15" W. Oak


Surveys by G. R. Boss, Oct. 1977, recorded
in Surveys L. 2, pgs. 593 - 596,
Fnd. 6' steel fence post
N05°E 11.8' Nail W/S 3' Ash
8.35' Nail E/S 4' Poplar
S75°E 110.30' Nail N/S 10" Ash

B. Description of corner evidence found and/or method applied in restoring or reestablishing corner:

M-12 E 1/4 cor., Sec. 36, T5N-R3E
Fnd. 6" diam. x 6' high steel post in conc. per L. 2, pgs.
593 - 596. Placed a Harrison marker cap in top of 6" pipe
as approved by the Shiawassee County Peer Review Group and is
accepted as the best available evidence of the position
of the original corner.

C. Description of monument for corner and accessories established to perpetuate locating the position of the corner:

M-12 E 1/4 cor., Sec. 36, T5N-R3E
Fnd. 6" diam. x 6' high steel post in conc. per L. 2, pgs.
593 - 596. Placed a Harrison marker cap in top of 6" pipe
as approved by the Shiawassee County Peer Review Group and is
accepted as the best available evidence of the position
of the original corner.
South 7.38' Set Nail & Tag #12018 W. side 5" Ash
S40°W 8.68' Set Nail & Tag #12018 E. side 10" Aspen
S22°W 18.65' Set Nail & Tag #12018 W. side 6" Aspen
S18°E 17.97' Set Nail & Tag #12018 W. side 5" Aspen

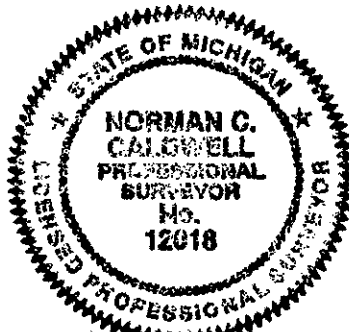

Signed by *Norman C. Caldwell* Date 20 NOV 93
Surveyor's Michigan License No. 12018