

**SURVEY & REMONUMENTATION**

DEC 15 1993

COMMISSION

**LAND CORNER RECORDATION CERTIFICATE**

Filing Requirement of Act 74, Mich. P.A. 1970  
REMONUMENTATION

RECORDED

93 DEC -6 AM 10:58

REGISTER OF DEEDS

SHIAWASSEE COUNTY, MICH.

For corners in

Shiawassee (County)	Located In:	Corner Code #
1. Public Land Survey	T 5N R 3E	M-13
	T R	
	T R	
	T R	
2. Property Controlling in Section	S T R	
	S T R	
3. Miscellaneous Property in Sec.	S T R	
	S T R	

Register of Deeds Stamp & File Number

- 4. Lot No. \_\_\_\_\_, Recorded Plat \_\_\_\_\_
- 5. Private Claims \_\_\_\_\_

	A	B	C	D	E	F	G	H	I	J	K	L	M
2	6		5		4		3		2				
3													
4	7		8		9		10		11		12		
5													
6	18		17		16		15		14		13		
7													
8	19		20		21		22		23		24		
9													
10	30		29		28		27		26		25		
11													
12	31		32		33		34		35		36		
13													

I, Norman C. Caldwell, in a field survey on November, 19 93, do hereby certify that under requirements of P.A. 74, Michigan P.A. of 1970, the corner points mentioned in lines 1 and 2 above were in conformance with regulations and rules therefore as required in the current manual of survey instructions of the United States Department of the Interior, Bureau of Land Management or by a decree of a Court of Law and/or that the corner points mentioned in lines 3, 4 and 5 above were in conformance with the rules of the Michigan Board of Land Surveyors or by a Decree of a Court of Law; established, re-established, monumented, re-monumented, recovered, found as expressed below:

**NOTE: Not more than 4 corners, all in the same town and range, may be recorded on this certificate.**

A. Description of original monument and accessories and/or subsequent restoration:

M-13 Twp. cor., T4 & 5N - R3 & 4E

Wood post place by J. Mullett, 1823  
S39°E 129 lks. (85.14') 4" W. Oak  
N63°W 57 lks. (37.62') 14" W. Oak

Surveys by G. R. Boss, 1977, recorded in Surveys L. 2, pgs. 593 - 596  
Fnd. 3/8" iron  
N76°E 72.32' Fnd. Nail S/S 36" Oak  
S67°E 77.92' Fnd. Nail N/S 40" Oak  
S17°E 77.95' Fnd. Nail W/S 20" Tree

L.C.R.C. by O. Boss, 1976, recorded in Corners L. 1, pg. 635,  
Fnd. 3/8" iron  
N76°E 72.32' Fnd. Nail S/S 36" Oak  
S67°E 77.92' Fnd. Nail N/S 40" Oak  
S17°E 77.95' Fnd. Nail W/S 20" Tree

B. Description of corner evidence found and/or method applied in restoring or reestablishing corner:

M-13 Twp. cor., T4 & 5N - R3 & 4E


Fnd. 1/2" rod (no cap) per L. 1, pg. 635 of corners, and L. 2, pgs. 593 - 596 of surveys. Replaced with a standard 20" Harrison marker as approved by the Shiawassee County Peer Review Group and is accepted as the best available evidence of the position of the original corner.

C. Description of monument for corner and accessories established to perpetuate locating the position of the corner:

M-13 Twp. cor., T4 & 5N - R3 & 4E

Fnd. 1/2" rod (no cap) per L. 1, pg. 635 of corners, and L. 2, pgs. 593 - 596 of surveys. Replaced with a standard 20" Harrison marker as approved by the Shiawassee County Peer Review Group and is accepted as the best available evidence of the position of the original corner.

N76°E 72.21' Fnd. spike S. face 36" Oak (R)  
S60°W 63.45' Fnd. Nail N. face Power Pole (R)  
S25°W 72.90' Set spike E. face 5" Oak  
North 21.78' W. leg traffic sign

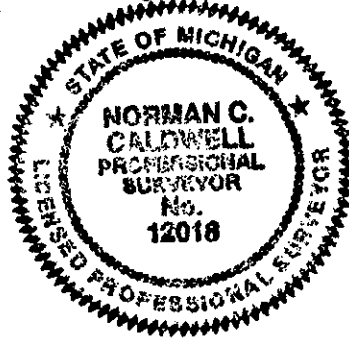

Signed by Norman C. Caldwell  
Surveyor's Michigan License No. 12018

Date 20 NOV 93