

SURVEY & REMONUMENTATION

AUG 05 1996

COMMISSION

LAND CORNER RECORDATION CERTIFICATE Filing Requirement of Act 74, Mich. P.A. 1970 REMONUMENTATION

RECORDED

93 DEC -6 AM 10:57

For corners in

<u>Shiawassee</u> (County)	Located In:	Corner Code #
1. Public Land Survey	T <u>5N</u> R <u>4E</u>	<u>M-12</u>
	T _____ R _____	_____
	T _____ R _____	_____
	T _____ R _____	_____
2. Property Controlling In Section	S _____ T _____ R _____	_____
	S _____ T _____ R _____	_____
3. Miscellaneous Property in Sec.	S _____ T _____ R _____	_____
	S _____ T _____ R _____	_____
4. Lot No. _____, Recorded Plat _____		
5. Private Claims _____		

REGISTER OF DEEDS
Hayes
SHIawassee COUNTY, MICH.

Register of Deeds Stamp & File Number

	A	B	C	D	E	F	G	H	I	J	K	L	M
2	6	5	4	3	2								
3													
4	7	8	9	10	11	12							
5													
6	18	17	16	15	14	13							
7													
8	19	20	21	22	23	24							
9													
10	30	29	28	27	26	25							
11													
12	31	32	33	34	35	36							
13													

I, Norman C. Caldwell, in a field survey on November, 19 93, do hereby certify that under requirements of P.A. 74, Michigan P.A. of 1970, the corner points mentioned in lines 1 and 2 above were in conformance with regulations and rules therefore as required in the current manual of survey instructions of the United States Department of the Interior, Bureau of Land Management or by a decree of a Court of Law and/or that the corner points mentioned in lines 3, 4 and 5 above were in conformance with the rules of the Michigan Board of Land Surveyors or by a Decree of a Court of Law; established, re-established, monumented, re-monumented, recovered, found as expressed below:

NOTE: Not more than 4 corners, all in the same town and range, may be recorded on this certificate.

A. Description of original monument and accessories and/or subsequent restoration:

M-12 E 1/4 cor., Sec. 36, T5N-R4E

Wood post placed by J. D. Mullett, 1848
North 10 lks. (6.60') 16" B. Oak
S50°E 10 lks. (6.60') 17" B. Oak

Survey by E. J. McCombs (C.P. Co.), 1973,
recorded in Surveys L. 1, pg. 484
Fnd. 3/4" pipe 16" below gravel road
brought to surface with 1/2" rebar
S80°W 31.04' Nail in 16" Oak
East 46.28' Nail in 16" Hickory
S40°E 66.09' Nail 10" Twin Oak
CL gravel and on line with fence to West

Survey by E. E. Anderson, 1976, recorded
in Surveys L. 2, pgs. 331 & 332
Fnd. monument box CL Sheridan Road and
tree line E and fence line to West
S30°E 66.14' Spike 10" Twin Oak
East 46.30' Tag 12" Hickory
S85°W 30.43' Iron in root 18" Oak

*P.G. 07
OCT 28, 1993*

B. Description of corner evidence found and/or method applied in restoring or reestablishing corner:


M-12 E 1/4 cor., Sec. 36, T5N-R4E

Fnd. 1/2" rebar in monument box per L. 1, pg. 484
and L. 2, pgs. 331 & 332. Replaced 1/2" rebar with a
standard 20" Harrison marker in monument box as approved
by the Shiawassee County Peer Review Group and is accepted
as the best available evidence of the position of the original cor.

C. Description of monument for corner and accessories established to perpetuate locating the position of the corner:

M-12 E 1/4 cor., Sec. 36, T5N-R4E

Fnd. 1/2" rebar in monument box per L. 1, pg. 484
and L. 2, pgs. 331 & 332. Replaced 1/2" rebar with a standard
20" Harrison marker in monument box as approved by the Shiawassee
County Peer Review Group and is accepted as the best
available evidence of the position of the original cor.
East 46.02' Set spike w/tag #12018 S face 18" Hickory (R-tree)
S85°W 30.56' Set spike w/tag #12018 SE face 30" Oak (R-tree)
S30°E 65.97' Set spike w/tag #12018 W face 20" Twin Oak (R-tree)
N50°W 42.37' Set spike w/tag #12018 SE face 12" Cherry

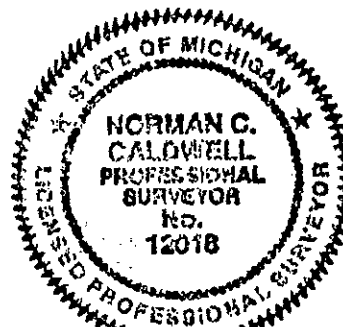

Signed by *Norman C. Caldwell*
Surveyor's Michigan License No. 12018

Date 20 NOV 93

11252 1 PG 1