

**SURVEY & REMONUMENTATION**

AUG 05 1996

COMMISSION

**LAND CORNER RECORDATION CERTIFICATE**  
**Filing Requirement of Act 74, Mich. P.A. 1970**  
**REMONUMENTATION**

RECORDED

93 DEC -6 AM 10:57

REGISTER OF DEEDS

*James H. ...*  
 SHIAWASSEE COUNTY, MICH.

Register of Deeds Stamp & File Number

For corners in Shiawassee (County) Located In: \_\_\_\_\_ Corner Code =# \_\_\_\_\_

1. Public Land Survey T 5N R 4E M-13  
 T \_\_\_\_\_ R \_\_\_\_\_  
 T \_\_\_\_\_ R \_\_\_\_\_  
 T \_\_\_\_\_ R \_\_\_\_\_

2. Property Controlling S \_\_\_\_\_ T \_\_\_\_\_ R \_\_\_\_\_  
 in Section S \_\_\_\_\_ T \_\_\_\_\_ R \_\_\_\_\_

3. Miscellaneous S \_\_\_\_\_ T \_\_\_\_\_ R \_\_\_\_\_  
 Property in Sec. S \_\_\_\_\_ T \_\_\_\_\_ R \_\_\_\_\_

4. Lot No. \_\_\_\_\_, Recorded Plat \_\_\_\_\_

5. Private Claims \_\_\_\_\_

	A	B	C	D	E	F	G	H	I	J	K	L	M
2	6	5	4	3	2	1							
3													
4	7	8	9	10	11	12							
5													
6	18	17	16	15	14	13							
7													
8	19	20	21	22	23	24							
9													
10	30	29	28	27	26	25							
11													
12	31	32	33	34	35	36							
13													

I, Norman C. Caldwell, in a field survey on November, 19 93, do hereby certify that under requirements of P.A. 74, Michigan P.A. of 1970, the corner points mentioned in lines 1 and 2 above were in conformance with regulations and rules therefore as required in the current manual of survey instructions of the United States Department of the Interior, Bureau of Land Management or by a decree of a Court of Law and/or that the corner points mentioned in lines 3, 4 and 5 above were in conformance with the rules of the Michigan Board of Land Surveyors or by a Decree of a Court of Law; established, re-established, monumented, re-monumented, recovered, found as expressed below:

NOTE: Not more than 4 corners, all in the same town and range, may be recorded on this certificate.

A. Description of original monument and accessories and/or subsequent restoration:

M-13 Township Corner T4 & 5N - R4 & 5E)

Wood post placed by J. Mullett, 1823  
 N64°E 16 lks. (10.56') 14" B. Oak  
 S44°W 11 lks. (7.26') 18" Elm

Survey by E. J. McCombs, (C.P. Co.), 1973, recorded in Surveys L. 1, pg. 484,  
 Fnd. "T" iron  
 N55°W 66.38' Nail 14" Oak  
 N40°W 59.55' Nail 16" Twin Oak  
 N45°E 55.93' Nail in Tele. Pole  
 S80°E 42.58' Nail Tele. Pole  
 6' South of CL E - W gravel, near CL gravel to North

Survey by E. E. Anderson, 1976, recorded in Surveys L. 2, pgs. 331 & 332  
 Fnd. "T" iron 1' below top gravel road  
 N45°W 59.25' Tag 20" Twin Oak  
 N60°E 72.17' Tag 12" Hickory  
 S10°E 91.8' E end 18" CMP  
 N45°E 46.0' Street sign post

B. Description of corner evidence found and/or method applied in restoring or reestablishing corner:

M-13 Township Corner T4 & 5N - R4 & 5E)


Fnd. 1/2" rebar w/smashed cap per references in L. 1, pg. 484 and L. 2, pg. 331 & 332, over record T-iron, two-1/2" rebars, a stone and remains of wood post at the corner position. Replaced with a standard 20" Harrison marker as approved by the Shiawassee County Peer Review Group and is accepted as the best available evidence of the position of the original corner.

*10/27/95*

C. Description of monument for corner and accessories established to perpetuate locating the position of the corner:

M-13 Township Corner T4 & 5N - R4 & 5E)

 N45°W 59.58' Fnd. PK E. face 20" Twin Oak (R)  
 N60°E 72.18' Fnd. Nail & Tag S face 12" Hickory (R)  
 S10°E 92.15' Chis. "+" E. end 18" CMP (R)  
 S25°W 92.93' Chis. "+" W. end 18" CMP

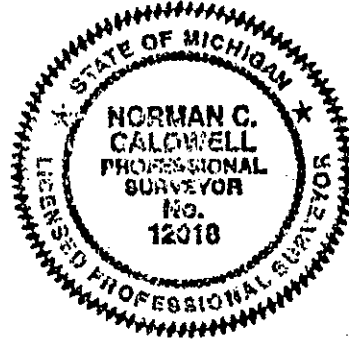

Signed by *Norman C. Caldwell* Date 20 NOV 93  
 Surveyor's Michigan License No. 12018