

**SURVEY & REMONUMENTATION**


MAY 28 1997

**LAND CORNER RECORDATION CERTIFICATE**  
Filing Requirement of Act 74, Mich. P.A. 1970

For corners in **COMMISSION**

<u>Shiawassee</u> (County)	Located in:	Corner Code #
1. Public Land Survey	T <u>6N</u> R <u>1E</u>	<u>C-13</u>
	T _____ R _____	_____
	T _____ R _____	_____
	T _____ R _____	_____
2. Property Controlling in Section	S _____ T _____ R _____	_____
	S _____ T _____ R _____	_____
3. Miscellaneous Property in Sec.	S _____ T _____ R _____	_____
	S _____ T _____ R _____	_____
4. Lot No. _____, Recorded Plat _____		
5. Private Claims _____		

**RECORDED**  
96 NOV 18 PM 3:39  
REGISTER OF DEEDS  
*Kaye Shultz*  
SHIAWASSEE COUNTY, MICH.

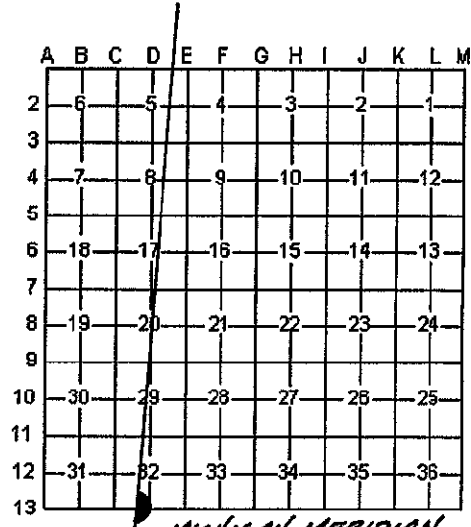

I, Mark L. VanRaemdonck, in a field survey on November 6, 1996, do hereby certify that under requirements of P.A. 74, Michigan P.A. of 1970, the corner points mentioned in lines 1 and 2 above were in conformance with regulations and rules therefore as required in the current manual of survey instructions of the United States Department of the Interior, Bureau of Land Management or by a decree of a Court of Law and/or that the current points mentioned in lines 3, 4 and 5 above were in conformance with the rules of the Michigan Board of Land Surveyors or by a Decree of a Court of Law; established, re-established, monumented, re-monumented, recovered, found as expressed below:

**NOTE: Not more than 4 corners, all in the same town and range, may be recorded on this certificate.**

**A. Description of original monument and accessories and/or subsequent restoration:**

- 1.) Original: Joseph Wampler, 1826  
Monument: Wood Post  
Accessories: Elm 16 S51°W 18 lks.  
Willow 5 N52°E 41 lks.
- 2.) Hollister, Field Book 2, 6/2/1896.  
Monument: Not given.  
Accessories: Not given.
- 3.) Lyman Mason, County Surveyor, June 1876  
Monument: Not given.  
Accessories: Not given.
- 4.) Jan S. Fokens, survey recorded Liber 3, page 633, 8/6/1982.  
Monument: Found 1" iron pipe  
Accessories: West 11.57' Found P.K. in 60" Willow  
South 3.25' Found P.K. in top of fence post  
N10°W 6.80' 10" Elm w/P.K.
- 5.) Jack N. Owens, survey recorded Liber 4, page 397, 2/25/1986.  
Monument: Found 1" iron pipe  
Accessories: West 11.57' Found P.K. in 60" Willow
- 6.) Jan S. Fokens, L.C.R.C. recorded Liber 2, page 329, 8/8/82.  
Monument: Found 1" iron pipe  
Accessories: West 11.57' P.K. in 60" Willow  
South 3.25' P.K. in top of fence post  
N10°W 6.80' Set P.K. in 10" Elm
- 7.) M. VanRaemdonck, survey recorded Liber 4, page 242, 12/10/84.  
Monument: Found 1" iron pipe  
Accessories: West 11.57' P.K. 60" Willow  
South 3.25' P.K. top fence post  
N10°W 6.80' P.K. 10" Elm
- 8.) Jack N. Owens, L.C.R.C. recorded Liber 2, page 417, 2/19/86.  
Monument: 1" iron pipe  
Accessories: Same as no. 5 above.

**B. Description of corner evidence found and/or method applied in restoring or reestablishing corner:**

Found 1" pipe as referenced in no. 4, 5, 6, 7 and 8 above. Accepted this location as the position of the original corner location based on the best available evidence. I established an amended corner location on the Michigan Meridian between corners M-12 and M-13, T6N-R1W, 12.73 feet East of the 1" pipe. Found no conflicting evidence.

**C. Description of monument for corner and accessories to perpetuate locating the position of the corner:**

Installed a standard Shiawassee County Harrison Marker monument at the amended corner location described above. The monument was stamped "REMON 24622" and is witnessed by the following accessories:

- N70°E 33.20' Set nail & tag #24622 in NW face 12" Ash
- S50°E 34.06' Set nail & tag #24622 in N. face 10" Ash
- East 26.08' Set nail & tag #24622 in N. face 5" Ash
- N60°W 35.17' Set nail & tag #24622 in NE face 4" Box Elder
- West 12.73' 1" pipe



Signed by *Mark L. VanRaemdonck*  
Surveyor's Michigan License No. 24622

Date Nov. 12, 1996

FORM APPROVED BY MICHIGAN STATE BOARD OF LAND SURVEYORS JAN 18, 1971  
REVISED MAY 14, 1975  
REVISED JAN., 1983

**APPROVED**

County Remonumentation  
Peer Review Group

**LIBER** 1R **PG** 175