

SURVEY & REMONUMENTATION

MAY 28 1997

LAND CORNER RECORDATION CERTIFICATE
Filing Requirement of Act 74, Mich. P.A. 1970

For corners in **COMMISSION**

Shiawassee Located in: _____ Corner Code # _____
(County)

1. Public Land Survey T 6N R 1E D-2
T _____ R _____
T _____ R _____
T _____ R _____


2. Property Controlling S _____ T _____ R _____
in Section S _____ T _____ R _____

3. Miscellaneous S _____ T _____ R _____
Property in Sec. S _____ T _____ R _____

4. Lot No. _____, Recorded Plat _____

5. Private Claims _____

RECORDED
96 NOV 18 PM 3:38
REGISTER OF DEEDS
Kyle Shultz
SHIAWASSEE COUNTY, MICH.
Register of Deeds Stamp & File Number

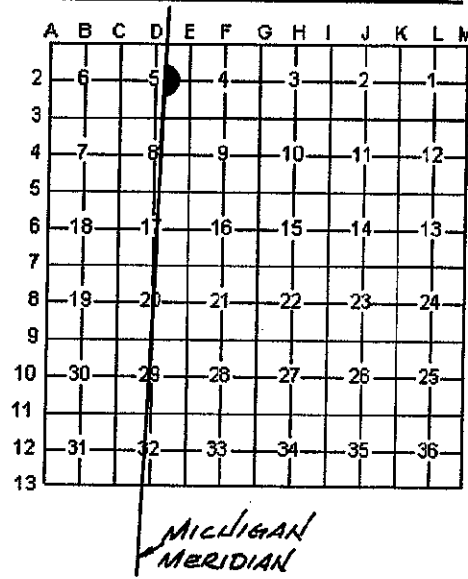

I, Mark L. VanRaemdonck, in a field survey on October 10, 1996, do hereby certify that under requirements of P.A. 74, Michigan P.A. of 1970, the corner points mentioned in lines 1 and 2 above were in conformance with regulations and rules therefore as required in the current manual of survey instructions of the United States Department of the Interior, Bureau of Land Management or by a decree of a Court of Law and/or that the current points mentioned in lines 3, 4 and 5 above were in conformance with the rules of the Michigan Board of Land Surveyors or by a Decree of a Court of Law; established, re-established, monumented, re-monumented, recovered, found as expressed below:

NOTE: Not more than 4 corners, all in the same town and range, may be recorded on this certificate.

A. Description of original monument and accessories and/or subsequent restoration:

Closing West 1/4 corner, Section 5, T6N-R1E
This position was not established by the original government survey
Found no record of establishment of this position by county surveyor

B. Description of corner evidence found and/or method applied in restoring or reestablishing corner:

Placed this position on the Michigan Meridian at 2640.00 feet North of the Southwest corner of Section 5 in accordance with "The Manual of Instructions for the Survey of the Public Lands of the United States," 1973 Edition Section 3-43, and the technical bulletin entitled "Restoration of Lost or Obliterated Corners and Subdivision of Sections," 1974 Edition Page 31.

No evidence was found during excavation for Harrison Marker.

C. Description of monument for corner and accessories to perpetuate locating the position of the corner:

Installed a standard Shiawassee Harrison Marker Monument Stamped "Remon 24622" and witnessed by the following accessories:
N75°E 27.85' Set nail & tag #24622 S. face 36" Maple
N35°E 47.26' Set nail & tag #24622 S. face 36" Maple
S80°W 25.88' Set nail & tag #24622 N. face 24" Walnut
N70°W 82.33 NE corner house #5158



Signed by Mark L. VanRaemdonck
Surveyor's Michigan License No. 24622

Date Nov. 11, 1996

LIBER 1 R PG 1104

APPROVED
11/13/96 MLV
County Remonumentation
Peer Review Group