

SURVEY & REMONUMENTATION

MAY 28 1997


LAND CORNER RECORDATION CERTIFICATE
Filing Requirement of Act 74, Mich. P.A. 1970

COMMISSION

For corners in

<u>Shiawassee</u> (County)	Located in:	Corner Code #
1. Public Land Survey	T <u>6N</u> R <u>1E</u>	<u>D-12</u>
	T _____ R _____	_____
	T _____ R _____	_____
	T _____ R _____	_____
2. Property Controlling in Section	S _____ T _____ R _____	_____
	S _____ T _____ R _____	_____
3. Miscellaneous Property in Sec.	S _____ T _____ R _____	_____
	S _____ T _____ R _____	_____
4. Lot No. _____, Recorded Plat _____		
5. Private Claims _____		

RECORDED
96 NOV 18 PM 3:39
REGISTER OF DEEDS
Kay Schmitt
SHIawassee COUNTY, MICH.

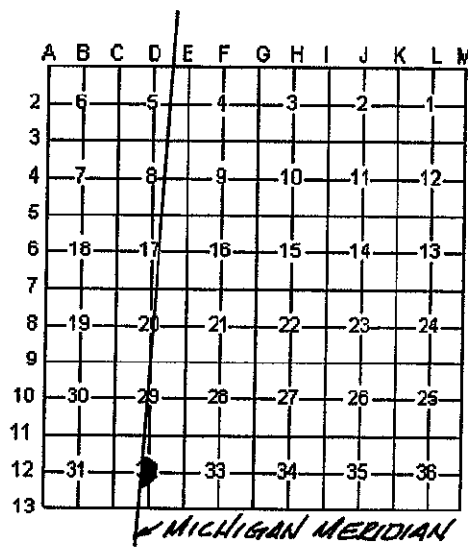

I, Mark L. VanRaemdonck, in a field survey on November 6, 1996, do hereby certify that under requirements of P.A. 74, Michigan P.A. of 1970, the corner points mentioned in lines 1 and 2 above were in conformance with regulations and rules therefore as required in the current manual of survey instructions of the United States Department of the Interior, Bureau of Land Management or by a decree of a Court of Law and/or that the current points mentioned in lines 3, 4 and 5 above were in conformance with the rules of the Michigan Board of Land Surveyors or by a Decree of a Court of Law; established, re-established, monumented, re-monumented, recovered, found as expressed below:

NOTE: Not more than 4 corners, all in the same town and range, may be recorded on this certificate.

A. Description of original monument and accessories and/or subsequent restoration:

Closing West 1/4 corner of Section 32, T6N-R1E. This position was not established in the original government survey.

- 1.) Hollister, Field Book 2, 6/2/1896.
Monument: Set flat stone
Accessories: G. Oak 10 N17°W 64 l.
- 2.) Lyman Mason, County Surveyor, June 1876.
Monument: Not given
Accessories: Cherry 5" S78 1/4°E 15
Y. Oak 14" S56 1/2°W 13 1/2
W. Oak 5" N17 1/4°E 8 1/2
- 3.) Hollister, Field Book 3, 6/2/1896.
Monument: Set flat stone

Accessories: G. Oak 10 N17°W 64 l.

- 4.) E.F. Joslin, 9/3/1904, Road Book 15B, page 128
Monument: Long stone on end at corner
Accessories: None given.
- 5.) Jack N. Owens, survey recorded Liber 4, page 397, 2/25/82.
Monument: Set 1/2" rod & cap
Accessories: N45°E 22.43' Set spike SE face 5" Oak
N15°E 15.55' Set spike W. face 4" Hickory
N15°W 16.92' Set spike E. face 6" Hickory
N04°11'35"W 52.76' T. fence post in conc.

B. Description of corner evidence found and/or method applied in restoring or reestablishing corner:

Could not find monuments or accessories as referenced in no. 1, 2, 3 and 4 above. Found rered & cap as referenced in no. 5 above. I accepted this location as the careful and faithful establishment of the original corner location based on the best available evidence. Excavation for Harrison Marker provided no further evidence.

C. Description of monument for corner and accessories to perpetuate locating the position of the corner:

Replaced rered and cap as referenced in no. 5 above with a standard Shiawassee County Harrison Marker monument. The marker is stamped "REMON 24622" and is witnessed by the following accessories:

- N80°W 3.78' Set nail & tag #24622 in S. face 8" Hickory
- S20°E 4.19' Set nail & tag #24622 in NE face 8" Hickory
- N15°E 15.39' Set nail & tag #24622 in SE face 10" Hickory
- S15°E 6.18' Set nail & tag #24622 in SE face 8" Hickory



Signed by Mark L. VanRaemdonck

Date Nov. 12, 1996

Surveyor's Michigan License No. 24622

FORM APPROVED BY MICHIGAN STATE BOARD OF LAND SURVEYORS JAN 18, 1971
REVISED MAY 14, 1975
REVISED JAN., 1983

APPROVED

11/13/96 MLV
County Remonumentation
Peer Review Group

LIBER 1B **PG** 174