

**SURVEY &  
REMONUMENTATION**

DEC 15 1993

RECORDED

COMMISSION

**LAND CORNER RECORDATION CERTIFICATE**  
Filing Requirement of Act 74, Mich. P.A. 1970

93 DEC -6 AM 11:00


For corners in  
Shiawassee

**REMONUMENTATION**

Located In: Corner Code #

(County)

- |                                       |   |    |   |    |      |
|---------------------------------------|---|----|---|----|------|
| 1. Public Land Survey                 | T | 6N | R | 1E | L-13 |
|                                       | T |    | R |    |      |
|                                       | T |    | R |    |      |
|                                       | T |    | R |    |      |
| 2. Property Controlling<br>in Section | S |    | T | R  |      |
|                                       | S |    | T | R  |      |
| 3. Miscellaneous<br>Property in Sec.  | S |    | T | R  |      |
|                                       | S |    | T | R  |      |
| 4. Lot No. _____, Recorded Plat _____ |   |    |   |    |      |
| 5. Private Claims _____               |   |    |   |    |      |

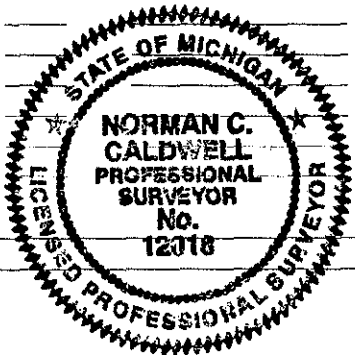

REGISTERED CLERK  
*[Signature]*  
SHIawassee COUNTY, MICH.

Register of Deeds Stamp & File Number

I, Norman C. Caldwell, in a field survey on November, 19 93, do hereby certify that under requirements of P.A. 74, Michigan P.A. of 1970, the corner points mentioned in lines 1 and 2 above were in conformance with regulations and rules therefore as required in the current manual of survey instructions of the United States Department of the Interior, Bureau of Land Management or by a decree of a Court of Law and/or that the corner points mentioned in lines 3, 4 and 5 above were in conformance with the rules of the Michigan Board of Land Surveyors or by a Decree of a Court of Law; established, re-established, monumented, re-monumented, recovered, found as expressed below:

| A  | B  | C  | D  | E  | F  | G  | H | I | J | K | L | M |
|----|----|----|----|----|----|----|---|---|---|---|---|---|
| 2  | 6  | 5  | 4  | 3  | 2  | 1  |   |   |   |   |   |   |
| 3  |    |    |    |    |    |    |   |   |   |   |   |   |
| 4  | 7  | 8  | 9  | 10 | 11 | 12 |   |   |   |   |   |   |
| 5  |    |    |    |    |    |    |   |   |   |   |   |   |
| 6  | 18 | 17 | 16 | 15 | 14 | 13 |   |   |   |   |   |   |
| 7  |    |    |    |    |    |    |   |   |   |   |   |   |
| 8  | 19 | 20 | 21 | 22 | 23 | 24 |   |   |   |   |   |   |
| 9  |    |    |    |    |    |    |   |   |   |   |   |   |
| 10 | 30 | 29 | 28 | 27 | 26 | 25 |   |   |   |   |   |   |
| 11 |    |    |    |    |    |    |   |   |   |   |   |   |
| 12 | 31 | 32 | 33 | 34 | 35 | 36 |   |   |   |   |   |   |
| 13 |    |    |    |    |    |    |   |   |   |   |   |   |

**NOTE: Not more than 4 corners, all in the same town and range, may be recorded on this certificate.**

**A. Description of original monument and accessories and/or subsequent restoration:**

L-13 1/4 cor., Sec. 36, T6N-R1E & Sec. 1, T5N-R1E

Wood post placed by J. Wampler, 1826,  
N84 1/2°E 28 lks. (18.48') 12" W. Oak  
N18°W 12.5 lks. ( 8.25') 8" Lynn

Survey by E. Mason, 1867, recorded in S.C.R.  
Book C, pg. 158 - 159.  
N84 1/2°E 28 lks. (18.48') 12" W. Oak

Survey by E. Mason, 1869, recorded in S.C.R.  
Book A, pg. 27  
N2 1/4°W 94.75 lks. (62.54') 12" Elm

Survey by A. S. Pierson, 1977, recorded in  
L. 2, pg. 610 of Surveys,  
Fnd. 3/4" pipe buried 14" Deep, raised  
with 1/2 rod & cap  
East 52.22' 8" Walnut  
N28°E 96.72' 20" Walnut  
N20°E 147.57' NW cor. old house foundation

Unrecorded survey by A. F. Miller, 1979,  
Fnd. PK over iron 2' E of CL  
N89°E 52.40' N & T 8" Walnut  
S75°E 35.92' N & T 4" Walnut  
N30°E 96.35' N & T 18" Walnut

Survey by A. F. Miller, 1978, recorded in L. 3,  
pg. 105 of Surveys  
Fnd. PK Nail over iron, 2' East of CL  
N89°E 52.40' N & T 8" Walnut  
S75°E 35.92' N & T 4" Walnut  
N30°E 96.35' N & T 18" Walnut

Survey by J. A. Sellak, 1980, recorded in L. 2, pg.  
228 of Corners & L. 3, pg. 444 & 445 & L. 4, pgs. 105  
202 & 203 of Surveys  
Iron w/PK Nail at surface per L. 3, pg. 105 of Surveys  
East 52.4' N & T 8" Walnut  
S60°E 36.33' N & T 4" Walnut  
S30°E 96.35' N & T 18" Walnut

Survey by L. A. Bryan, 1985, recorded in L. 5, pgs. 779 & 780  
Fnd. 1/2" bar w/cap #13039 2.5' East of CL Fenner Road on fence  
lines E & W, per L. 2, pg. 228  
East 52.35' Fnd. PK N & W N. side 8" Walnut  
N30°E 96.72' Fnd. PK Nail NW side 18" Walnut  
S55°W 175.70' NW cor. foundation house #90301

**B. Description of corner evidence found and/or method applied in restoring or reestablishing corner:**

L-13 1/4 cor., Sec. 36, T6N-R1E & Sec. 1, T5N-R1E

Fnd. 1/2" rod w/unreadable cap per L. 2, pg. 228 of corners and L. 2, pg. 610, L. 3, pgs. 105, 444 & 445, L. 4, pgs. 105, 202 & 203 and L. 5, pgs. 779 & 780 of surveys. Replaced with a standard 20" Harrison marker in monument box as approved by the Shiawassee Co. peer Review Group and is accepted as the best available evidence of the position of the orig. cor.

**C. Description of monument for corner and accessories established to perpetuate locating the position of the corner:**

L-13 1/4 cor., Sec. 36, T6N-R1E & Sec. 1, T5N-R1E

Fnd. 1/2" rod w/unreadable cap per L. 2, pg. 228 of corners and L. 2, pg. 610, L. 3, pgs. 105, 444 & 445, L. 4, pgs. 105, 202 & 203 and L. 5, pgs. 779 & 780 of surveys. Replaced with a standard 20" Harrison marker in monument box as approved by the Shiawassee County peer Review Group and is accepted as the best available evidence of the position of the original corner. East 52.06' Set N & T N. face 12" Walnut (R - tree)  
S55°W 175.65' NW cor. foundation house #9030 (R)  
S50°E 22.37' Chis. "+" top center N. end 12" conc. culvert  
S10°E 39.70' Chis. "+" top center S. end 12" conc. culvert

Signed by Norman C. Caldwell  
Surveyor's Michigan License No. 12018

Date 2 DEC 93