

OLNEY &
ASSOCIATES
SURVEYORS


2011

LAND CORNER RECORDATION CERTIFICATE
Filing Requirement of Act 74, Mich. P.A. 1970

SECTION
For corners in

Located in: Shiawassee (County)
Corner Code #: M-7


1. Public Land Survey	T <u>6N</u> R <u>1E</u>	<u>_____</u>
	T <u>_____</u> R <u>_____</u>	<u>_____</u>
	T <u>_____</u> R <u>_____</u>	<u>_____</u>
	T <u>_____</u> R <u>_____</u>	<u>_____</u>
2. Property Controlling In Section	S <u>_____</u> T <u>_____</u> R <u>_____</u>	<u>_____</u>
	S <u>_____</u> T <u>_____</u> R <u>_____</u>	<u>_____</u>
3. Miscellaneous Property in Sec.	S <u>_____</u> T <u>_____</u> R <u>_____</u>	<u>_____</u>
	S <u>_____</u> T <u>_____</u> R <u>_____</u>	<u>_____</u>
4. Lot No. _____	Recorded Plat _____	<u>_____</u>
5. Private Claims _____		<u>_____</u>

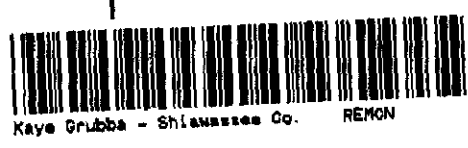

3026115
Page: 1 of 1
10/05/1998 02:19P
L-1 P-308

Register of Deeds Stamp
& File Number

I, Mark L. VanRaemdonck, in a field survey on February 19, 1999, do hereby certify that under requirements of P.A. 74, Michigan P.A. of 1970, the corner points mentioned in lines 1 and 2 above were in conformance with regulations and rules therefore as required in the current manual of survey instructions of the United States Department of the Interior, Bureau of Land Management or by a decree of a Court of Law and/or that the corner points mentioned in lines 3, 4 and 5 above were in conformance with the rules of the Michigan Board of Land Surveyors or by a Decree of a Court of Law; established, re-established, monumented, re-monumented, recovered, found as expressed below:

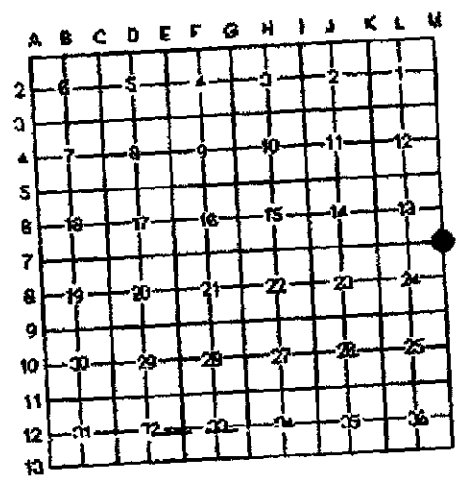

NOTE: Not more than 2 corners, all in the same town and range, may be recorded on this certificate.

A. Description of original monument and accessories and/or subsequent restoration:

- Original, Joseph Wampler, D.S. 1824
Mon: Wood Post
Accessories: Tam 10 S76°W 104LKS
Willow 2 N65°W 5LKS
- County Surveyor, 1916E, Shiawassee County Road Book 11, page 78.
Mon: "Put iron pipe South side of old stake"
Accessories: None Given
- John F. Quine, LCRC, Recorded Liber 2, page 26, November 29, 1976.
Mon: Found rusty 3/4" pipe 0.2' South of rotted wood stake. Brought to surface with magnetized 1/2"x18" iron rod, yellow plastic cap stamped "JFQ RLS 10704" set directly above wooden stake.
Accessories: N40°W 40.35' Wooden corner fence post
N38°W 37.2' 3"x6" iron pipe road name sign post
N35°E 28.6' CL of N. face of conc. bridge deck at center guard rail post
East 17.65' CL of S. face of conc. bridge deck at center guard rail post
North 2.8' S. edge of seal coat pavement
North 12.1' CL of seal coat pavement

APPROVED

County Remonumentation
Peer Review Group

1 OCT 99
NCL

B. Description of corner evidence found and/or method applied in restoring or re-establishing corner.

Found Quine rerod (bent) at location reference in No. 3 above. Found rust pipe 2.4' below surface. Found no conflicting evidence. I accepted this location as the careful and faithful perpetuation of the original corner position.

C. Description of monument for corner and accessories to perpetuate locating the position of the corner.

Installed a standard Shiawassee County Harrison marker monument in a monument box, at the location described in Section B above. The marker is stamped "Remon P.S. 24622" and is witnessed by the following accessories:
North 21.04' R&C #12018 in mon. box cor. A-7, T6N-R2E
N30°W 37.65' S. face 3" pipe post
S30°E 23.52' Top cen. S. end 72" CMP
N25°E 44.55' Hole in top N. end 72" CMP
North 13.80' CL asphalt surface Brewer Road

Signed by Mark L. VanRaemdonck

Surveyor's Michigan License No. 24622

Date SEPT. 23, 1999

