

SURVEY & REMONUMENTATION

NOV 10 1997

COMMISSION

LAND CORNER RECORDATION CERTIFICATE
Filing Requirement of Act 74, Mich. P.A. 1970

RECORDED

97 NOV -6 PM 2:37

REGISTER OF DEEDS

Kaye Shultz
SHIAWASSEE COUNTY, MICH.

For corners in

<u>Shiawassee</u> (County)	Located in:	Corner Code #
1. Public Land Survey	T <u>6N</u> R <u>1E</u>	<u>M-9</u>
	T _____ R _____	_____
	T _____ R _____	_____
	T _____ R _____	_____
2. Property Controlling In Section	S _____ T _____ R _____	_____
	S _____ T _____ R _____	_____
3. Miscellaneous Property in Sec.	S _____ T _____ R _____	_____
	S _____ T _____ R _____	_____
4. Lot No. _____, Recorded Plat _____		
5. Private Claims _____		

Register of Deeds Stamp & File Number

I, Mark L. VanRaemdonck, in a filed survey on ~~January 4~~ ^{JUNE 11-13} 1997, do hereby certify that under requirements of P.A. 74, Michigan P.A. of 1970, the corner points mentioned in lines 1 and 2 above were in conformance with regulations and rules therefore as required in the current manual of survey instructions of the United States Department of the Interior, Bureau of Land Management or by a decree of a Court of Law and/or that the corner points mentioned in lines 3, 4 and 5 above were in conformance with the rules of the Michigan Board of Land Surveyors or by a Decree of a Court of Law; established, re-established, monumented, re-monumented, recovered, found as expressed below.

NOTE: Not more than 4 corners, all in the same town and range, may be recorded on this certificate.

A. Description of original monument and accessories and/or subsequent restoration:


- Original: Joseph Wampler, DS 2/1824
Mon: Wood Post
Access: W. Oak 15 N24°W 47
B. Oak 9° S87°W 25
- Ezra Mason Book B&C Pages 194-195 12/2/1870
Mon: Not Given
Access: NW Cor of Barn S72 1/4°E 92
B. Oak 10° S79 1/4°W 164 1/2
- E. S. Brewer, L. C. R. C. Rec. Liber 1, Page 160 11/3/1973
Mon: 1" Iron Pipe
Access: Cen Mail Box Post N13°E 14.0
Cen 18" Apple Tree N64 3/4°E 55.5
Cen 24" Black Walnut S1 1/4°E 59.0
Cen 18" Black Walnut N60°W 57.0
- Mark L. VanRaemdonck, Cert. Survey, Rec. L. 6, P. 479 3/25/1993
Mon: Found 3/4" Pipe
Access: N10°E 23.15' N&T E. face 15" Maple
N50°W 47.50' N&T S. face 8" Walnut
South 33.00' Rerod & Cap #24622
S03°W 2.07' Found 1/2" Pipe at NW cor Sec. 30, T6N-R2E

	A	B	C	D	E	F	G	H	I	J	K	L	M
2	6	5	4	3	2	1							
3													
4	7	8	9	10	11	12							
5													
6	13	17	16	15	14	13							
7													
8	19	20	21	22	23	24							
9													
10	30	29	28	27	26	25							
11													
12	31	32	33	34	35	36							
13													

APPROVED

County Remonumentation
Peer Review Group

31 OCT 97
NCL

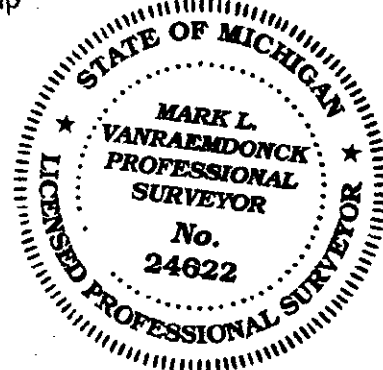

B. Description of corner evidence found and/or method applied in restoring or re-establishing corner:

Found 1" Iron Pipe as referenced in No. 3 and 4 above. Also found 1/2" Pipe 2.07 feet South of 1" Pipe. Also found 1" by 2" bar 1.23 feet South of 1/2" Pipe. G. L. O. map shows that M-9, T6N-R1E is located 2 links South of corner A-9 of T6N-R2E (0.02 X 66 = 1.32). The locations of the 1" by 2" bar and the 1/2" pipe are in the correct relationship with the G. L. O. If the bar is accepted as corner M-9. Brewer's L. C. R. C. does not mention the other irons and states he drove Pipe on centerline of Road. The bar is located 5280.83 feet North of corner M-11 which is in close accord with the GLO distance (80 CH, 5280 feet). Both the bar and the 1/2" Pipe appear to have been in place at the time of Brewer's Survey. I accepted the location of the 1" by 2" bar as the original corner position on the best available evidence. Found a 12" ± stone beneath the bar.

C. Description of monument for corner and accessories to perpetuate locating the position of the corner

Installed a standard Shiawassee County Harrison Marker, stamped "Remon 24622" at the location described above. The marker is witnessed by the following:

- | | |
|--------------|---|
| N50°W 49.05' | N&T S. face 10" Walnut |
| N60°W 58.18' | N&T S. face 24" Walnut |
| N10°E 26.47' | N&T 25832 E. face 18" Maple |
| N50°E 57.65' | N&T 25832 NW face 24" Apple |
| North 1.23' | Rerod & cap #24622 at cor. A-9, T6N-R2E |
| North 3.30' | 3/4" Pipe set by E. S. Brewer |

Signed by Mark L. VanRaemdonck

Date OCT. 29, 1997

Surveyor's Michigan License No. 24622

LIBER R OPG 224