

**SURVEY &  
REMONUMENTATION**

DEC 15 1993

RECORDED

93 DEC -6 AM 11:00

**LAND CORNER RECORDATION CERTIFICATE  
Filing Requirement of Act 74, Mich. P.A. 1970  
REMONUMENTATION**

For corners in  
Shiawassee

REGISTER OF DEEDS  
*Spencer*  
SHIWAASSEE COUNTY, MICH.

	Located In:		Corner Code #/
	(County)		
1. Public Land Survey	6N	1E	M-11
	T	R	
	T	R	
	T	R	
2. Property Controlling in Section	S	T	R
	S	T	R
3. Miscellaneous Property in Sec.	S	T	R
	S	T	R

Register of Deeds Stamp & File Number

4. Lot No. \_\_\_\_\_, Recorded Plat \_\_\_\_\_  
5. Private Claims \_\_\_\_\_

I, Norman C. Caldwell, in a field survey on November, 1993, do hereby certify that under requirements of P.A. 74, Michigan P.A. of 1970, the corner points mentioned in lines 1 and 2 above were in conformance with regulations and rules therefore as required in the current manual of survey instructions of the United States Department of the Interior, Bureau of Land Management or by a decree of a Court of Law and/or that the corner points mentioned in lines 3, 4 and 5 above were in conformance with the rules of the Michigan Board of Land Surveyors or by a Decree of a Court of Law; established, re-established, monumented, re-monumented, recovered, found as expressed below:

**NOTE: Not more than 4 corners, all in the same town and range, may be recorded on this certificate.**

	A	B	C	D	E	F	G	H	I	J	K	L	M
2	6	5	4	3	2	1							
3													
4	7	8	9	10	11	12							
5													
6	18	17	16	15	14	13							
7													
8	19	20	21	22	23	24							
9													
10	30	29	28	27	26	25							
11													
12	31	32	33	34	35	36							
13													

**A. Description of original monument and accessories and/or subsequent restoration:**

M-11 Sec. cor., 25 & 36, T6N-R1E

Wood post placed by J. Wampler, 1826,  
N38°W 22 lks. (14.52') 18" W. Oak  
S57°W 25 lks. (16.50') 12" W. Oak

Survey by Ezra Mason, Co. Surveyor,  
recorded in Book A, S.C.R. pg. 27  
S73 3/4°W 31.5 lks. (20.79') 3" W. Oak

Surveys by L. A. Bryan, 1983 - 1987, recorded in  
L. 2, pg. 393 of Corners, and L. 5, pgs. 516 - 519,  
650 - 652, & 796 - 797 of Surveys  
Fnd. plow point in N - S, W. fence lines  
N10°W 14.38' Set N & T SW side 6" Cherry  
N85°E 221.15' Set N & T N. side 30" Hickory  
South 183.95' Set N & T E. side 8" Cherry

**B. Description of corner evidence found and/or method applied in restoring or reestablishing corner:**

M-11 Sec. cor., 25 & 36, T6N-R1E


Fnd. plow point per L. 2, pg. 393 of Corners & L. 5,  
pgs. 516 - 519, 650 - 652, & 796 - 797 of Surveys,  
Replaced with a standard 20" Harrison marker as  
approved by the Shiawassee County Peer Review Group  
and is accepted as the best available evidence of  
the position of the original corner.

NOTE: In excavation, found a second plow point,  
directly below the first one.

**C. Description of monument for corner and accessories established to perpetuate locating the position of the corner:**

M-11 Sec. cor., 25 & 36, T6N-R1E

Fnd. plow point per L. 2, pg. 393 of Corners & L. 5,  
pgs. 516 - 519, 650 - 652, & 796 - 797 of Surveys,  
Replaced with a standard 20" Harrison marker as  
approved by the Shiawassee County Peer Review Group  
and is accepted as the best available evidence of  
the position of the original corner.  
N03°W 37.47' Fnd. 1/2" bar w/#6515 cap @ Closing Cor., Sec. 30/31, T6N-R3E  
S20°W 24.44' Set N & T #12018 E. face 4" Box Elder  
N10°W 14.37' Set N & T #12018 E. face 8" Cherry  
S75°W 14.78' Set N & T #12018 N. face Box Elder  
South 1'± Set REI Carsonite Witness Post

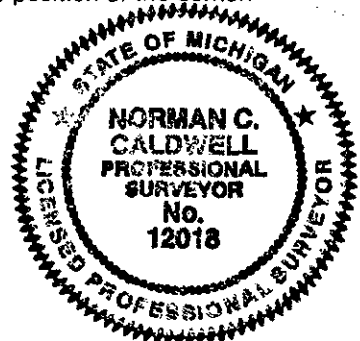

Signed by *Norman C. Caldwell* Date 2 DEC 93  
Surveyor's Michigan License No. 12018