

SURVEY & REMONUMENTATION

NOV 10 1997

LAND CORNER RECORDATION CERTIFICATE
Filing Requirement of Act 74, Mich. P.A. 1970

RECORDED

97 NOV -6 PM 2:38

For corners in **COMMISSION**

REGISTER OF DEEDS
Spay Shuster
SHIAWASSEE COUNTY, MICH.

Shiawassee (County)	Located in:	Corner Code #
1. Public Land Survey	T <u>6N</u> R <u>4E</u>	<u>K-10</u>
	T _____ R _____	_____
	T _____ R _____	_____
	T _____ R _____	_____
2. Property Controlling In Section	S _____ T _____ R _____	_____
	S _____ T _____ R _____	_____
3. Miscellaneous Property in Sec.	S _____ T _____ R _____	_____
	S _____ T _____ R _____	_____
4. Lot No. _____	Recorded Plat _____	
5. Private Claims _____		

Register of Deeds Stamp & File Number

I, Mark L. VanRaemdonck, in a filed survey on March 20, 1997, do hereby certify that under requirements of P.A. 74, Michigan P.A. of 1970, the corner points mentioned in lines 1 and 2 above were in conformance with regulations and rules therefore as required in the current manual of survey instructions of the United States Department of the Interior, Bureau of Land Management or by a decree of a Court of Law and/or that the corner points mentioned in lines 3, 4 and 5 above were in conformance with the rules of the Michigan Board of Land Surveyors or by a Decree of a Court of Law; established, re-established, monumented, re-monumented, recovered, found as expressed below:

NOTE: Not more than 2 corners, all in the same town and range, may be recorded on this certificate.


A. Description of original monument and accessories and/or subsequent restoration:

- Original John Mullett, D.S. 1823
Mon: Wood Post
Access: Beech 8 S6E 20 LKS
W. Oak 10N17W LKS
- Edwin J. McCombs, L. C. R. C. Rec. L1, P53, 6/29/72
Mon: Found nail in Centerline
Access: Iron West 33.00 feet
- Consumers Power Co. unrecorded Survey 6/16/72
Mon: None Given
Access: Found Iron 33' W. of Rd. Centerline
- E. S. Brewer, unrecorded survey dated 6/9/87
Mon: Nail in Centerline
Access: Iron 33. feet West
- Norman C. Caldwell, L. C. R. C. Rec. L2, P. 606, 3/10/89
Mon: Rod & Cap #20709 Set from Gould references
Access: N20°E 100.24' N&T W. Face T. P.
West 33.00' "T" Iron
S30°E 42.15' W. edge RR cross. Sn. Post
S20°W 147.13' TC N. end 12' conc. culv.
N10°W 184.23' P. K. & T. TC. 18" Stump
- Mark L. VanRaemdonck, Cert. Surv. Rec. L6, P. 834, 5/26/94
Mon: R&C #20709
Access: S20°E 100.24' N&T W. face T. P.
West 33.00' "T" Iron
S30°E 42.15' W. edge RR cross. Sn. Post
S20°W 147.13' TC N. end 12' conc. culv.
N10°W 184.23' P. K. & T. TC. 18" Stump

	A	B	C	D	E	F	G	H	I	J	K	L	M
2	6	5	4	3	2	1							
3													
4	7	8	9	10	11	12							
5													
6	13	17	16	15	14	13							
7													
8	19	20	21	22	23	24							
9													
10	25	29	28	27	26	25							
11													
12	31	32	33	34	35	36							
13													

APPROVED
County Remonumentation
Peer Review Group

31 OCT 97
NCC

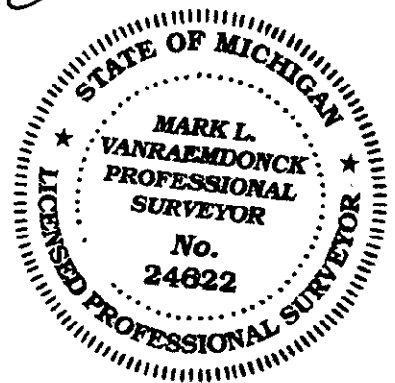

B. Description of corner evidence found and/or method applied in restoring or re-establishing corner:
Found Rerod and Cap #20709 as referenced in No. 4 above and is accepted as the Best available evidence of the position of the original corner.

C. Description of monument for corner and accessories to perpetuate locating the position of the corner
Installed a standard Shiawassee County Harrison Marker, stamped "Remon 24622." The marker is witnessed by the following accessories:
S45°W 99.40' Set P. K. & tag N. face 12" Twin Ash
S20°E 103.76' Set P. K. & tag W. face Util. Pole
West 19.16' Set R&C #24622 on Shoulder of Road
N75°E 29.04' Cut Notch Top Cen. S. end 14" CMP
N50°E 41.72' Cut Notch Top Cen. N. end 14" CMP

Signed by Mark L. VanRaemdonck

Date OCT. 29, 1997

Surveyor's Michigan License No. 24622

Form approved by Michigan State Board of Land Surveyors
JAN 18, 1971
Revised May 14, 1975
Revised Jan., 1983

LIBER R PG 24/1000