

**SURVEY & REMONUMENTATION**

NOV 10 1997

COMMISSION

**LAND CORNER RECORDATION CERTIFICATE**  
Filing Requirement of Act 74, Mich. P.A. 1970

RECORDED

97 NOV -6 PM 2:37

For corners in

<u>Shiawassee</u> (County)	Located in:	Corner Code #
1. Public Land Survey	T <u>6N</u> R <u>3E</u>	<u>K-9</u>
	T _____ R _____	_____
	T _____ R _____	_____
	T _____ R _____	_____
2. Property Controlling In Section	S _____ T _____ R _____	_____
	S _____ T _____ R _____	_____
3. Miscellaneous Property in Sec.	S _____ T _____ R _____	_____
	S _____ T _____ R _____	_____
4. Lot No. _____	Recorded Plat _____	
5. Private Claims _____		

REGISTER OF DEEDS  
*Hayes Shubert*  
SHIAWASSEE COUNTY, MICH.

Register of Deeds Stamp & File Number

I, Mark L. VanRaemdonck, in a filed survey on March 28, 1997, do hereby certify that under requirements of P.A. 74, Michigan P.A. of 1970, the corner points mentioned in lines 1 and 2 above were in conformance with regulations and rules therefore as required in the current manual of survey instructions of the United States Department of the Interior, Bureau of Land Management or by a decree of a Court of Law and/or that the corner points mentioned in lines 3, 4 and 5 above were in conformance with the rules of the Michigan Board of Land Surveyors or by a Decree of a Court of Law; established, re-established, monumented, re-monumented, recovered, found as expressed below:

NOTE: Not more than 4 corners, all in the same town and range, may be recorded on this certificate.


A. Description of original monument and accessories and/or subsequent restoration:

- Original John Mullett, D. S. 1823  
Mon: Wood Post  
Access: B. Oak 36 West 17  
Hickory 5 N73°E 6
- John Quine, Unrecorded Survey Aug. 5, 1964  
Mon: 6" Diameter Wooden corner Post 4 feet High

**APPROVED**

County Remonumentation  
Peer Review Group

*NCC 37*  
*31 OCT 97*

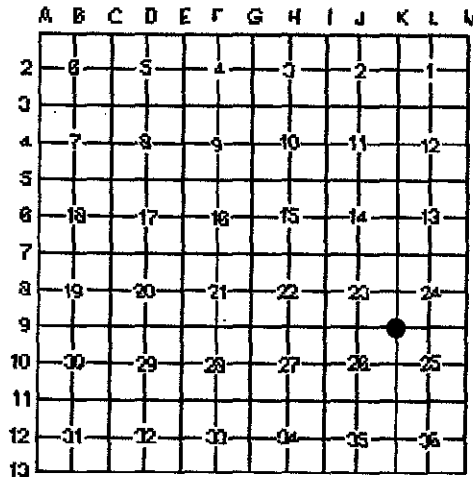

B. Description of corner evidence found and/or method applied in restoring or re-establishing corner:

Found 10" Dia. Wood Post 5' high at intersection of East and West fence and fence running South. Found remains of 6" Wood post 4' long on East side of 10" Post. This location fits well with GLO distance along North line of Section 25 (GLO = 5272.08, MEA .5275.65). I accepted this location as the original corner position based on the best available evidence.

C. Description of monument for corner and accessories to perpetuate locating the position of the corner

Installed a standard Shiawassee County Harrison Marker, stamped "Remon 24622" on the East side of the 10" Wood Anchor Post. The marker is witnessed by the following accessories:

- |       |        |                                  |
|-------|--------|----------------------------------|
| East  | 26.64' | N&T 24622 in S. face 8" Elm      |
| S50°E | 14.23' | N&T 24622 in W. face 6" Ash      |
| South | 19.71' | N&T 24622 in W. face 10" Elm     |
| N80°E | 5.18'  | N&T 24622 in N. face 24" Ash     |
| N54°E | 28.73' | Rerod & cap #24622 (Trav. Point) |

Signed by *Mark L. VanRaemdonck*  
Surveyor's Michigan License No. 24622

Date OCT. 31, 1997

FORM APPROVED BY MICHIGAN STATE BOARD OF LAND SURVEYORS JAN 18, 1971  
REVISED MAY 14, 1975  
REVISED JAN., 1983



**LIBER** IR **PG** 234