

**SURVEY &
REMONUMENTATION**

NOV 10 1997

**LAND CORNER RECORDATION CERTIFICATE
Filing Requirement of Act 74, Mich. P.A. 1970**

97 NOV -6 PM 2:38

COMMISSION

For corners in

REGISTER OF DEEDS
Sage Mullett
SHIAWASSEE COUNTY, MICH.

<u>Shiawassee</u> (County)	Located in:	Corner Code #
1. Public Land Survey	T <u>6N</u> R <u>3E</u>	<u>M-10</u>
	T _____ R _____	_____
	T _____ R _____	_____
	T _____ R _____	_____
2. Property Controlling In Section	S _____ T _____ R _____	_____
	S _____ T _____ R _____	_____
3. Miscellaneous Property in Sec.	S _____ T _____ R _____	_____
	S _____ T _____ R _____	_____
4. Lot No. _____, Recorded Plat _____		
5. Private Claims _____		

Register of Deeds Stamp & File Number

I, Mark L. VanRaemdonck, in a filed survey on March 28, 1997, do hereby certify that under requirements of P.A. 74, Michigan P.A. of 1970, the corner points mentioned in lines 1 and 2 above were in conformance with regulations and rules therefore as required in the current manual of survey instructions of the United States Department of the Interior, Bureau of Land Management or by a decree of a Court of Law and/or that the corner points mentioned in lines 3, 4 and 5 above were in conformance with the rules of the Michigan Board of Land Surveyors or by a Decree of a Court of Law, established, re-established, monumented, re-monumented, recovered, found as expressed below:

A	B	C	D	E	F	G	H	I	J	K	L	M
2	6	5	4	3	2	1						
3												
4	7	8	9	10	11	12						
5												
6	18	17	16	15	14	13						
7												
8	19	20	21	22	23	24						
9												
10	30	29	28	27	26	25						
11												
12	31	32	33	34	35	36						
13												

NOTE: Not more than 4 corners, all in the same town and range, may be recorded on this certificate.

A. Description of original monument and accessories and/or subsequent restoration:

- Original John Mullett, D. S. 1823
Mon: Wood Post
Access: W. Oak 12 S70°W 14
B. Oak 5 N11°W 22
- Andrew Huggins, County Surveyor, Book B, Page 19, May 23, 1849
Mon: None Given
Access: White Oak 12 N55°W 56
W. Oak 18 S26 1/2 W 75
- O. M. Elliot, County Surveyor, Book F, Page 97, Field Book 19, Page 30 7/25/1951
Mon: Iron in Road
Access: 24" Double Oak SW 46 feet
14" Elm NW 29.4

APPROVED
County Remonumentation
Peer Review Group

NCC
31 OCT 97

B. Description of corner evidence found and/or method applied in restoring or re-establishing corner:

Found Double Oak witness tree from No. 3 above but was unable to locate the "Iron in Road." Due to unreliability of Elliot's Work, I declared that original corner position lost. I re-established the corner position using the single proportion method.


C. Description of monument for corner and accessories to perpetuate locating the position of the corner

Installed a standard Shiawassee County Harrison Marker, stamped "Remon 24622" at the location described above. The marker is witnessed by the following accessories:

S40°W	31.93'	Carlson N&T in NW face Twin 24" Black Oak
N80°W	28.09'	Carlson N&T in NE face 36" Black Oak
N85°E	45.19'	Carlson N&T N. face 18" Walnut
South	10.50'	Carlson Rerod & Cap
N35°E	87.23'	Set N&T in W. face 24" Red Oak

Signed by *Mark L. VanRaemdonck*
Surveyor's Michigan License No. 24622

Date OCT. 28 1997 24622

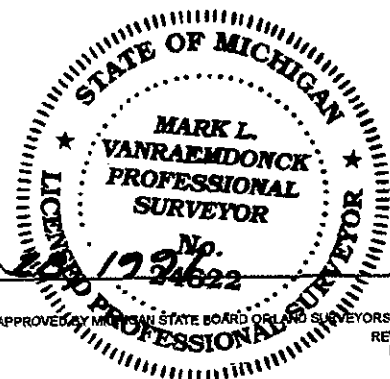

FORM APPROVED BY MICHIGAN STATE BOARD OF LAND SURVEYORS JAN 18, 197
REVISED MAY 14, 197
REVISED JAN. 198