

SURVEY & REMONUMENTATION

SEP 29 1994

COMMISSION

LAND CORNER RECORDATION CERTIFICATE
Filing Requirement of Act 74, Mich. P.A. 1970

RECORDED
94 SEP -6 11:11:06
REGISTER OF DEEDS
Kayla Shultz
SHIAWASSEE COUNTY, MICH.

For corners in

<u>Shiawassee</u> (County)	Located In:	Corner Code #
1. Public Land Survey	T <u>6N</u> R <u>3E</u>	<u>M-12</u>
	T _____ R _____	_____
	T _____ R _____	_____
	T _____ R _____	_____
2. Property Controlling in Section	S _____ T _____ R _____	_____
	S _____ T _____ R _____	_____
3. Miscellaneous Property in Sec.	S _____ T _____ R _____	_____
	S _____ T _____ R _____	_____
4. Lot No. _____, Recorded Plat _____		
5. Private Claims _____		

Register of Deeds Stamp & File Number

	A	B	C	D	E	F	G	H	I	J	K	L	M
2	6	5	4	3	2	1							
3													
4	7	8	9	10	11	12							
5													
6	18	17	16	15	14	13							
7													
8	19	20	21	22	23	24							
9													
10	30	29	28	27	26	25							
11													
12	31	32	33	34	35	36							
13													

I, Norman C. Caldwell, in a field survey on July, 19 94, do hereby certify that under requirements of P.A. 74, Michigan P.A. of 1970, the corner points mentioned in lines 1 and 2 above were in conformance with regulations and rules therefore as required in the current manual of survey instructions of the United States Department of the Interior, Bureau of Land Management or by a decree of a Court of Law and/or that the corner points mentioned in lines 3, 4 and 5 above were in conformance with the rules of the Michigan Board of Land Surveyors or by a Decree of a Court of Law; established, re-established, monumented, re-monumented, recovered, found as expressed below.

NOTE: Not more than 4 corners, all in the same town and range, may be recorded on this certificate.

A. Description of original monument and accessories and/or subsequent restoration:

M-12 1/4 cor., Common to Sec. 36, T6N-R3E, & Sec. 31 T6N-R4E

Wood post placed by J. Mullett, 1823
N31°W 70 lks. (46.20') 5" B. Oak
S12°W 128 lks. (84.48') 6" B. Oak

Survey by E. Mason, County Surveyor,
June 1883, recorded in County Surveyors
records 1879-1900 pgs. 104-105 S.C.R.
Mon. & Refs Not Given

B. Description of corner evidence found and/or method applied in restoring or reestablishing corner:

M-12 1/4 cor., Common to Sec. 36, T6N-R3E, & Sec. 31 T6N-R4E

Calc. a position for this corner using County Surveyors measurements. Dug a 8' x 8' x 3' hole, fnd. a 42" x 24" x 30" boulder, remains of a wood post, a bearing race and chunks of coal all surrounded by rocks 18" below road surface. Set a std. 20" Harrison Marker 12" below road surface 4'± E of CL as approved by the Shiawassee County Remon. Peer Review Group and is accepted as the best available evidence of the position of the original corner.

Measurements along the range line agree with E. Mason Survey of 1883.


C. Description of monument for corner and accessories established to perpetuate locating the position of the corner:

M-12 1/4 cor., Common to Sec. 36, T6N-R3E, & Sec. 31 T6N-R4E

Calc. a position for this corner using County Surveyors measurements. Dug a 8' x 8' x 3' hole, fnd. a 42" x 24" x 30" boulder, remains of a wood post, a bearing race and chunks of coal all surrounded by rocks 18" below road surface. Set a std. 20" Harrison Marker 12" below road surface 4'± E of CL as approved by the Shiawassee County Remon. Peer Review Group and is accepted as the best available evidence of the position of the original corner.

N37°E 31.88' Set N & T #12018 S. fc. 28" Cottonwood
N65°W 35.43' Set N & T #12018 N. fc. N'ly stem of 12" Oak
S40°W 31.52' Set N & T #12018 NW fc. 4" Elm
S30°E 54.69' Set N & T #12018 NW fc. 12" Elm

APPROVED
County Remonumentation
Peer Review Group
8/16/94 M.L.V.

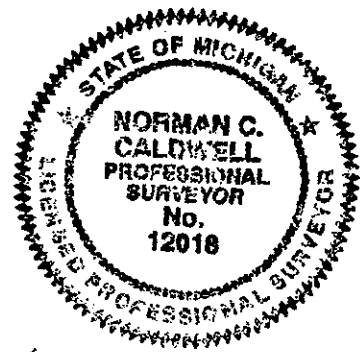

Signed by *Norman C. Caldwell* Date 16 AUG 94

Surveyor's Michigan License No. 12018