

SURVEY & REMONUMENTATION COMMISSION

MAY 28 1997

REMONUMENTATION

RECORDED

LAND CORNER RECORDATION CERTIFICATE

95 AUG 16 PM 2:38

Filing Requirement of Act 74, Mich. P.A. 1970

REGISTER OF DEEDS

Layne Shuster
SHIAWASSEE COUNTY, MICH.

For corners in <u>Shiawassee</u> (County)	Located In:	Corner Code #
1. Public Land Survey	T 7N R 1E	D-12 (W 1/4 32)
	T R	
	T R	
	T R	
2. Property Controlling in Section	S T R	
	S T R	
3. Miscellaneous Property in Sec.	S T R	
	S T R	
4. Lot No. _____, Recorded Plat _____		
5. Private Claims _____		

Register of Deeds Stamp & File Number

	A	B	C	D	E	F	G	H	I	J	K	L	M
1													
2	6		5		4		3		2		1		
3													
4	7		8		9		10		11		12		
5													
6	18		17		16		15		14		13		
7													
8	19		20		21		22		23		24		
9													
10	30		29		28		27		26		25		
11													
12	31		32		33		34		35		36		
13													

I, Norman C. Caldwell, in a field survey on April 1996, do hereby certify that under requirements of P.A. 74, Michigan P.A. of 1970, the corner points mentioned in lines 1 and 2 above were in conformance with regulations and rules therefore as required in the current manual of survey instructions of the United States Department of the Interior, Bureau of Land Management or by a decree of a Court of Law and/or that the corner points mentioned in lines 3, 4 and 5 above were in conformance with the rules of the Michigan Board of Land Surveyors or by a Decree of a Court of Law; established, re-established, monumented, re-monumented, recovered, found as expressed below:

NOTE: Not more than 4 corners, all in the same town and range, may be recorded on this certificate.

A. Description of original monument and accessories and/or subsequent restoration:

D-12 Closing Section Corner of Sections 28 & 33, T 7 N, R 4 E, Middlebury Township.

This position not monumented by the original government survey.
There is no record which indicates subsequent establishment or use of this position.

B. Description of corner evidence found and/or method applied in restoring or reestablishing corner:

D-12 Closing Section Corner of Sections 28 & 33, T 7 N, R 4 E, Middlebury Township.

Following an extensive search, it was determined that there is no monument representing this position and it is therefore established on the Michigan Meridian at a mid point between the closing section corners of section 33.

There is no apparent conflicting evidence and this position is accepted as a careful and faithful determination of the position of the corner.

Approved by the joint Clinton/Shiawassee County Remonumentation peer group 22 May 1996.

C. Description of monument for corner and accessories established to perpetuate locating the position of the corner:


D-12 Closing Section Corner of Sections 28 & 33, T 7 N, R 4 E, Middlebury Township.

Placed a standard Harrison monument on the Michigan Meridian at a mid point between the Closing Section Corners of section 33 and in line with ancient fence South.
(Open field to the North)

References:

- N 45 E 28.90' Chiseled "T" on top of large rock
- S 30 E 68.40' 12018 tag in 15" elm
- S 30 W 56.35' 12018 tag in 8" Ash
- S 45 W 39.50' 12018 tag in 5" Ash

Signed by *Norman C. Caldwell* Date 31 MAY 1996
Surveyor's Michigan License No. 12018

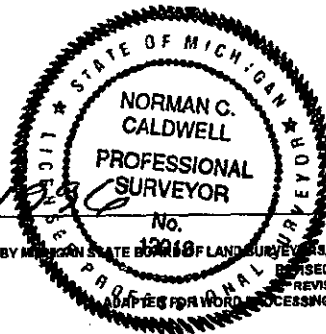

FORM APPROVED BY MICHIGAN STATE BOARD OF LAND SURVEYORS, JAN. 28, 1971
REVISED MAY 14, 1975
REVISED JAN. 1983
ADAPTED FOR WORD PROCESSING MARCH, 1993

APPROVED
5/22/96 MCV
County Remonumentation
Peer Review Group

LIBER 1R PG 161