LAND CORNER RECORDATION CERTIFICATE Filing Requirement of Act 74, Mich. P.A. 1970

Shlawassee (County)	Located in:	Corner Code #
1. Public Land Survey	T_7N_R_2E_ TR TR	K-9
2. Property Controlling In Section	STR S T R	
Miscellaneous Property in Sec.	S T R	
4. Lot No. 5. Private Claims	, Recorded Plat	

SURVEY & REMONUMENTATION

NOV 0 3 1998

SECTION

R ^

3

S

ā

9

10 11 12

Register of Deeds Stamp & File Number

DEFG4

APPROVED

County Remonumentation

Peer Review Group

NCC 7 OCT98

MARK L

VANRAEMDONCK *

PROFESSIONAL

SURVEYOR

NO.

24622

I, Mark L. VanRaemdonck, in a field survey on June 25, 1998, do hereby certify that under requirements of P.A. 74, Michigan P.A. of 1970, the corner points mentioned in lines 1 and 2 above were in conformance with regulations and rules therefore as required in the current manual of survey instructions of the United States Department of the Interior, Bureau of Land Management or by a decree of a Court of Law and/or that the corner points mentioned in lines 3, 4 and 5 above were in conformance with the rules of the Michigan Board of Land Surveyors or by a Decree of a Court of Law; established, re-established, monumented, re-monumented, recovered, found as expressed below:

NOTE: Not more than 2 corners, all in the same town and range, may be recorded on this certificate.

A. Description of original monument and accessories and/or subsequent restoration:

- Original, William Brookfield, D.S. November 26, 1623 Monument: Wood post Accessories: Sugar 16 S82 ½°E 57 Ironwood 9 N22 ½°W 17 1.
- Fletcher Gould, County Surveyor Field Book, CR-33, page 107, August 12, 14, 15, 1911 Monument: Not given
 Accessories: Elm 22 N33°W 49 links
 S. Oak 12 N50°14'W 87 feet Elm 24 \$15°E 52 links
- Fletcher Gould, County Surveyor Field Book, CR-38, 6/26/1917 Monument: Not given

Accessories: Hydrant N45°E 43.75° S45°E 50,25

NW cor, of 2 ½ sq. stone pillar S. Oak 36 N50°W 88.40′

State Highway Project #76011 A, File #76011, 009, sheet 27, C.E. Smith, Dec. 1965 Monument: 3/4" iron in mon. box Accessories: \$46"W 33.55" tele pole N38"E 44.38' power pole

N42"E 43.00' hydrant

S41°E 46.40' tele pole N42°E 43.00' hydrant


John Quine, LCRC recorded Liber 1, page 296, 2/24/75, date of survey December 1965 Monument: Found 3/4" iron 12" deep in 8" cast iron mon. box Accessories: Tele. pole S46"W 33.55' Tele. pole S41 "E 46.40 Power pole N38"E 44.38' Fire hydrant N42"E 43.0' (references fumished by MDSH, CE Smith Party Chief, December 1965) 5

Mark VanRaemdonck, Certified Survey, recorded Liber 4, page 664, 9/29/87 Monument: Found rerod in mon. box Accessories: S41°E 46.40' tele. pole N38°E 44.38' tele. pole

N42°E 43.00' hydrant

N38°E 44.38' tele. pole S40°W 39.75' tele. pole

- Mark VanRaemdonck, Certified Survey recorded Liber 5, page 181, 1/12/89 Monument and Accessories same as No. 6 above
- Mark VanRaemdonck, Certified Survey recorded Liber 6, page 623, 12/17/93 Monument and Accessories same as No. 6 above
- Glen Fauser, Certified Survey recorded Liber 8, page 068, 12/3/97 Monument: Found monument box Accessories: Accessories: None given
- B. Description of corner evidence found and/or method applied in restoring or re-establishing corner: Found 3/4" pipe in monument box as referenced in No.'s 3,4,5 and 6 above. I found a second 3/4" pipe below the first one. I drove the second pipe to 24" below the asphalt surface. I accepted this location as the original corner position based on the best available evidence. Found no conflicting evidence.

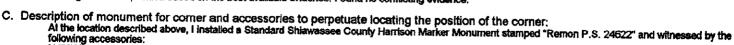

TOHOWING accessories:	
N40°W	35.78'
\$45°W	40.09
S45°E	46.16
N42°E	42.76
S45°E	50.54
N45°E	18.88

SE face road name sign post Set N&T 24622 in NW face util, pole Set N&T 24622 in W face util, pole Top 5 sided nut fire hydrant NW cor. stone pillar Cen. water valve box cover

Surveyor's Michigan License No

3007692 Page: 1 of 1 10/27/1998 03:22P Date 5EPT 23 1998

FORM APPROVED BY MICHIGAN STATE BOARD OF LAND SURVEYORS

JAN 18, 1971 REVISED MAY 14, 1975 REVISED JAN., 1983

| h-1 Pa-245