

**LAND CORNER RECORDATION CERTIFICATE**  
**Filing Requirement of Act 74, Mich. P.A. 1970**

For corners in

Shiawassee Located in: \_\_\_\_\_ Corner Code # \_\_\_\_\_  
 (County)

1. Public Land Survey T 7N R 2E \_\_\_\_\_ M-9 \_\_\_\_\_  
 T \_\_\_\_\_ R \_\_\_\_\_  
 T \_\_\_\_\_ R \_\_\_\_\_  
 T \_\_\_\_\_ R \_\_\_\_\_

2. Property Controlling S \_\_\_\_\_ T \_\_\_\_\_ R \_\_\_\_\_  
 In Section S \_\_\_\_\_ T \_\_\_\_\_ R \_\_\_\_\_

3. Miscellaneous S \_\_\_\_\_ T \_\_\_\_\_ R \_\_\_\_\_  
 Property in Sec. S \_\_\_\_\_ T \_\_\_\_\_ R \_\_\_\_\_

4. Lot No. \_\_\_\_\_ Recorded Plat \_\_\_\_\_

5. Private Claims \_\_\_\_\_

SURVEY &  
 REMONUMENTATION

NOV 03 1998

SECTION

Register of Deeds Stamp  
 & File Number

3007713  
 Page: 1 of 2  
 10/27/1998 03:22P



Kaye Grubba - Shiawassee Co. REMON Lb-1 Pg-266

I, Mark L. VanRaemdonck, in a field survey on July 21, 1998, do hereby certify that under requirements of P.A. 74, Michigan P.A. of 1970, the corner points mentioned in lines 1 and 2 above were in conformance with regulations and rules therefore as required in the current manual of survey instructions of the United States Department of the Interior, Bureau of Land Management or by a decree of a Court of Law and/or that the corner points mentioned in lines 3, 4 and 5 above were in conformance with the rules of the Michigan Board of Land Surveyors or by a Decree of a Court of Law, established, re-established, monumented, re-monumented, recovered, found as expressed below:

**NOTE: Not more than 2 corners, all in the same town and range, may be recorded on this certificate.**

**A. Description of original monument and accessories and/or subsequent restoration:**

1. Original, Joseph Wampler, D.S. circa 1823  
 Monument: Wood post  
 Accessories: Ash 14 S2°E 30 Maple 13 N43°W 149
2. Ezra Mason, County Surveyor, March 23 and 24, 1869  
 Monument: Not given Accessories: None given
3. County Surveyors Records, CR-74, page 135  
 Monument: Not given  
 Accessories: B. Walnut 6 S50°E 58 1/4 S. Maple 6 N43°10'E 45
4. Fletcher Gould, County Surveyor, his field book #12, page 60, 1946  
 Monument: Stake is next to big fence brace post  
 Accessories: 36" Oak West 25.25'  
 24" Oak N35°W 38.80'  
 5" Birch S5°E 5.35'  
 Corner 19 and 30 is 43 LKS North of corner of Section 24 and 25. 3/8" rod in conc.
5. E.S. Brewer, LCRC recorded 11/07/86 Liber 2, page 453  
 Monument: West end of flower directly above East edge of "H" of Josephine Lampman headstone.  
 Accessories: North 28.38' monument for Sections 19 and 30 for Caledonia Twp.  
 Rowell family monument is 213 feet West on the North line of Section 25, and the Christian Mausoleum is approximately 50 feet East on South side of drive from Northeast corner of Section 25.
6. John D. Matonich, Jr. LCRC recorded Liber 2, page 529, 6/22/88  
 Monument: Found 3/4" pipe at Southeast Section 24, T7N-R2E, using previous witnesses  
 Accessories: N85°E 14.75' tag #11192 in W face 20" Maple  
 N30°W 39.74' tag #11192 in ENE face 38" Oak  
 S50°W 57.57' top NE cor. of fig. of "Christian" family mausoleum  
 North 29.75' rod in conc. at NW cor., Section 30, T7N-R3E

|    |    |    |    |    |    |    |   |   |   |   |   |   |   |
|----|----|----|----|----|----|----|---|---|---|---|---|---|---|
|    | A  | B  | C  | D  | E  | F  | G | H | I | J | K | L | M |
| 2  | 6  | 5  | 4  | 3  | 2  | 1  |   |   |   |   |   |   |   |
| 3  |    |    |    |    |    |    |   |   |   |   |   |   |   |
| 4  | 7  | 8  | 9  | 10 | 11 | 12 |   |   |   |   |   |   |   |
| 5  |    |    |    |    |    |    |   |   |   |   |   |   |   |
| 6  | 18 | 17 | 16 | 15 | 14 | 13 |   |   |   |   |   |   |   |
| 7  |    |    |    |    |    |    |   |   |   |   |   |   |   |
| 8  | 19 | 20 | 21 | 22 | 23 | 24 |   |   |   |   |   |   |   |
| 9  |    |    |    |    |    |    |   |   |   |   |   |   |   |
| 10 | 30 | 29 | 28 | 27 | 26 | 25 |   |   |   |   |   |   |   |
| 11 |    |    |    |    |    |    |   |   |   |   |   |   |   |
| 12 | 31 | 32 | 33 | 34 | 35 | 36 |   |   |   |   |   |   |   |
| 13 |    |    |    |    |    |    |   |   |   |   |   |   |   |

**APPROVED**

County Remonumentation  
 Peer Review Group

NCC 7 OCT 98

**B. Description of corner evidence found and/or method applied in restoring or re-establishing corner:**

Found 3/4" pipe 0.3 feet South of headstone of Josephine Lampman and 29.75 feet South of a 3/8" rod in concrete (corner A-9, T7N-R3E). The position described by Brewer in No. 5 above is 1.37 feet North of pipe and 28.38 feet (43 links) South of the 3/8" rod in concrete. I re-established the corner location on line between corner A-9, T7N-R3E and corner M-10, T7N-R3E at a distance of 28.38 feet (43LKS) from corner A-9, T7N-R3E. I accepted this location as the careful and faithful re-establishment of the original corner position based on the best available evidence.

**C. Description of monument for corner and accessories to perpetuate locating the position of the corner:**

Since the corner location is on a headstone, no corner monument was set. The following accessories were established:

|                            |        |                                                        |
|----------------------------|--------|--------------------------------------------------------|
| N89°04'04"W (on sec. line) | 2.58'  | 1/2" pipe                                              |
| N00°27'42"E                | 28.38' | rerod in conc., corner A-9, T7N-R3E                    |
| S00°08'29"W                | 1.39'  | pipe with alum cap stamped "Ref. Mon."                 |
| East                       | 14.94' | found nail & tag 11192 in W face 30" Maple             |
| N30°W                      | 38.58' | Head of frd. bent nail with tag in ENE face of 38" Oak |

See graphic on reverse

(OVER)

Signed by Mark L. VanRaemdonck

Date SEPT. 24, 1998


Surveyor's Michigan License No. 24622



SURVEY &  
REMONUMENTATION

NOV 08 1998

SECTION

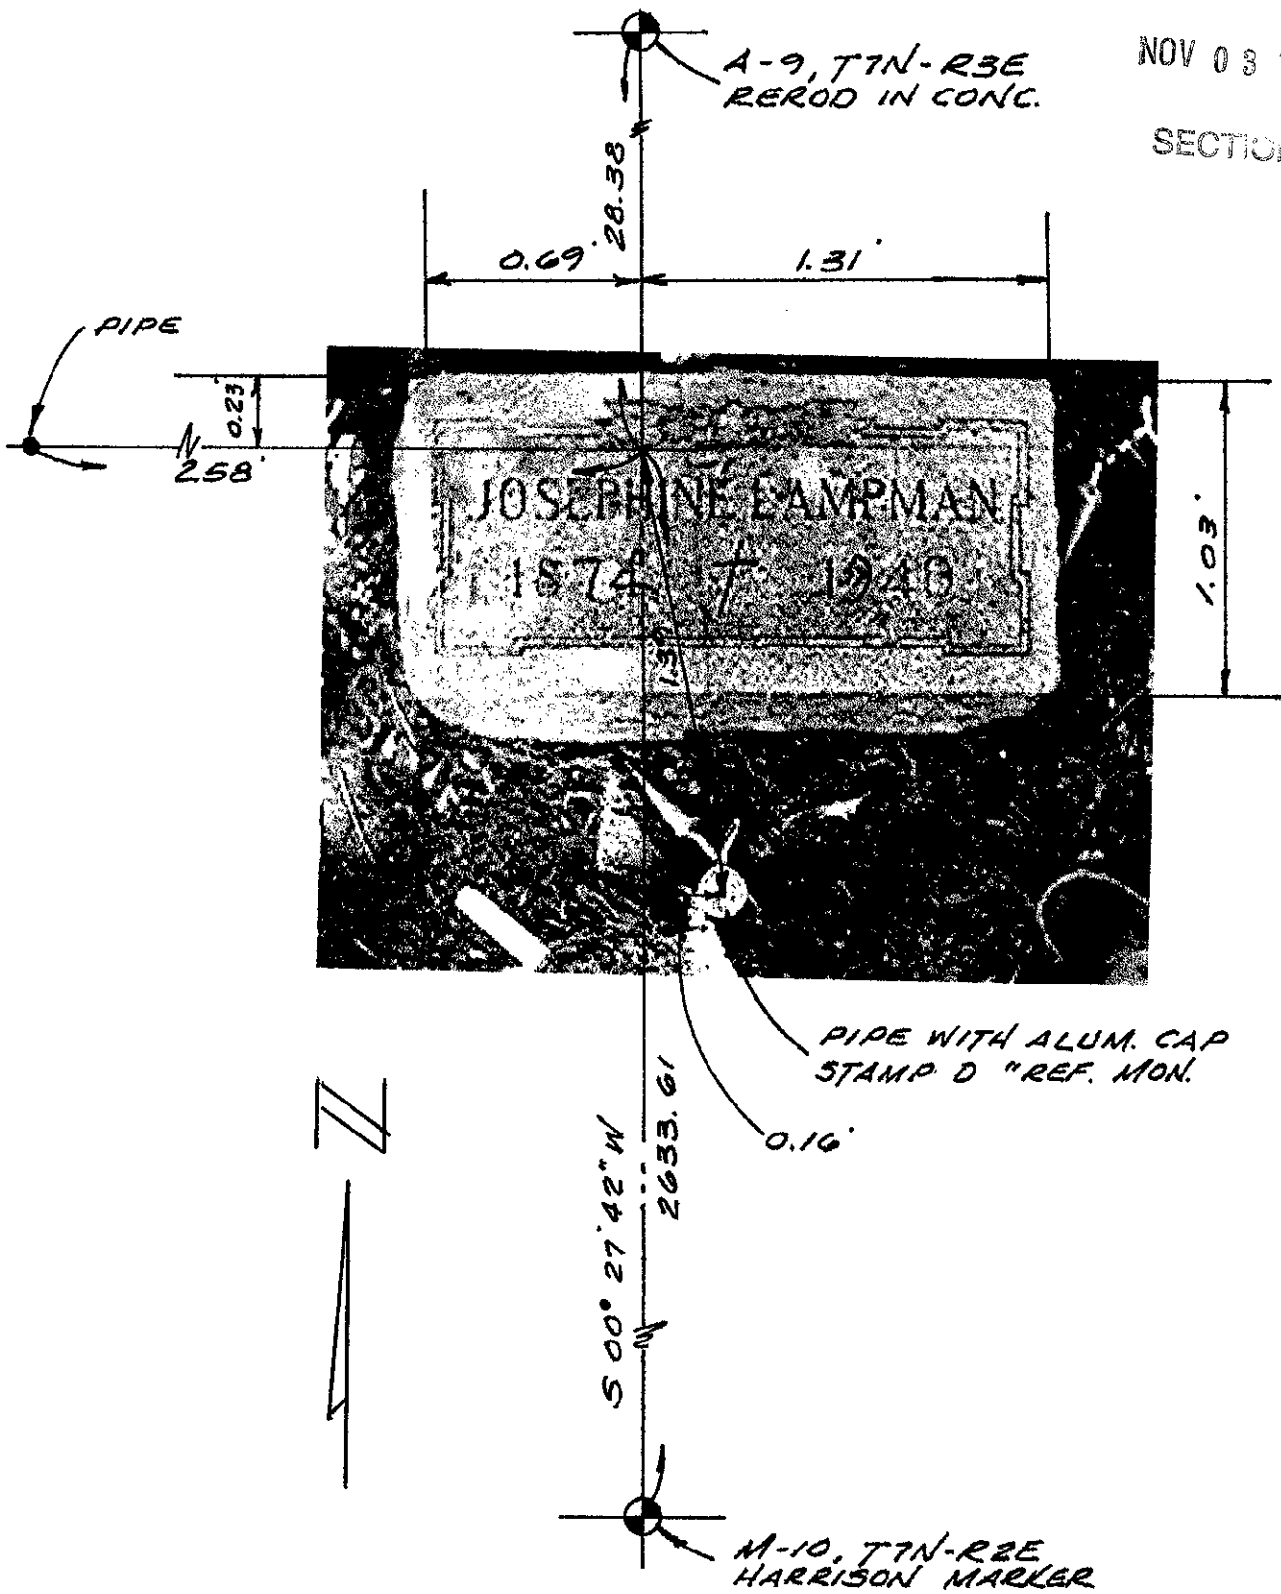

3007713  
Page: 2 of 2  
10/27/1998 03:22P