

1998 REMONUMENTATION PROGRAM
LAND CORNER RECORDATION CERTIFICATE
Filing Requirement of Act 74, Mich. P.A. 1970

SURVEY &
 REMONUMENTATION

NOV 03 1998

SECTION

For corners in

Shiawassee Located In: Corner Code #
 (County) Caledonia Twp



3007711
 Page: 1 of 1
 10/27/1998 03:22P
Lb-1 Pg-264

- | | | | |
|-------------------------|----|----|---|
| 1. Public Land Survey | T | R | L |
| | 7N | 3E | 9 |
| 2. Property Controlling | T | R | |
| in Section | S | T | R |
| 3. Miscellaneous | S | T | R |
| Property in Sec. | S | T | R |

Register of Deeds Stamp & File Number

4. Lot No. _____ Recorded Plat _____
 5. Private Claims _____

	A	B	C	D	E	F	G	H	I	J	K	L	M
1													
2	6	5	4	3	2	1							
3													
4	7	8	9	10	11	12							
5													
6	18	17	16	15	14	13							
7													
8	19	20	21	22	23	24							
9													
10	30	29	28	27	26	25							
11													
12	31	32	33	34	35	36							
13													

I, John H. Rauser, P.S., in a field survey on Feb. 26 and Sept. 03 1998, do hereby certify that under requirements of P.A. 74, Michigan P.A. of 1970, the corner points mentioned in lines 1 and 2 above were in conformance with regulations and rules therefore as required in the current manual of survey instructions of the United States Department of the Interior, Bureau of Land Management or by a decree of a Court of Law and/or that the corner points mentioned in lines 3, 4 and 5 above were in conformance with the rules of the Michigan Board of Land Surveyors or by a Decree of a Court of Law; established, re-established, monumented, re-monumented, recovered, found as expressed below:

NOTE: Not more than 2 corners, all in the same town and range, may be recorded on this certificate.

A. Description of original monument and accessories and/or subsequent restoration:
L-9 Common 1/4 Cor., Secs. 24,25, T7N-R3E, Caledonia Township, Shiawassee County


- 1822 Wood post placed by J. Wampler, D.S. Lynn 6" N16W 17 lks
 Elm 9" S29W 33 lks
- 1866 County Survey Record by E. Mason, C.S. Mason's Book I, P. 106; no witnesses given. Measured distance to M-9 is 39.5 ch (2607') with bearing of S88.75W.
- 1917 Minutes of survey of Hathon Drain by Bruce Robinson; notes drain crossing N-S 1/4 line 12 chains South of corner.

B. Description of corner evidence found and/or method applied in restoring or reestablishing corner:
L-9 Common 1/4 Cor., Secs. 24,25, T7N-R3E, Caledonia Township, Shiawassee County

Found stone at base of rotted anchor post 0.3' below surface. Stone fits remnants of fence lines running N-S & E-W. Found no evidence of original government corner. Distance measured to M-9 2597.51 feet (R= 1866, 2607.0 feet), no other measurements of record. Found no conflicting evidence of corner. Accept position of stone as the best available evidence of the position of the original government corner.

C. Description of monument for corner and accessories established to perpetuate locating the position of the corner:
L-9 Common 1/4 Cor., Secs. 24,25, T7N-R3E, Caledonia Township, Shiawassee County

- Set a standard 20" Harrison monument at the position approved by the Shiawassee County Peer review Group.
- S15W 20.24' Set nail with tag #39096 in E Fce 12" Elm
 - S30E 30.30' Set nail with tag #39096 in E Fce 14" R. Oak
 - N45E 14.89' Set nail with tag #39096 in NW Fce 10" Ash
 - N88W 26.83' Set nail with tag #39096 in S Fce 11" Ash

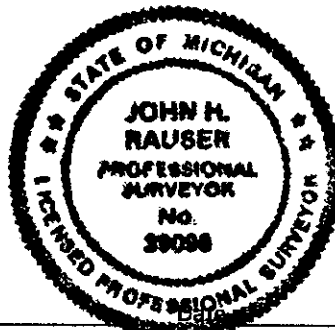

Signed by John H. Rauser
 Surveyor's Michigan License No. 39096

10/21/98