

**SURVEY &
REMONUMENTATION**

SEP 29 1994

**LAND CORNER RECORDATION CERTIFICATE
Filing Requirement of Act 74, Mich. P.A. 1970**

RECORDED
94 SEP -6 AM 11:05

For corners in **COMMISSION**

REGISTER OF DEEDS

Lloyd Shultz
SHIAWASSEE COUNTY, MICH.

Shiawassee (County)	Located In:	Corner Code #
1. Public Land Survey	T 7N R 4E	M-12
	T _____ R _____	_____
	T _____ R _____	_____
	T _____ R _____	_____
2. Property Controlling in Section	S _____ T _____ R _____	_____
	S _____ T _____ R _____	_____
3. Miscellaneous Property in Sec.	S _____ T _____ R _____	_____
	S _____ T _____ R _____	_____

Register of Deeds Stamp & File Number

4. Lot No. _____, Recorded Plat _____
5. Private Claims _____

APPROVED

County Remonumentation

Peer Review Group

8/16/94 M.L.V.

I, Norman C. Caldwell, in a field survey on July, 19 94, do hereby certify that under requirements of P.A. 74, Michigan P.A. of 1970, the corner points mentioned in lines 1 and 2 above were in conformance with regulations and rules therefore as required in the current manual of survey instructions of the United States Department of the Interior, Bureau of Land Management or by a decree of a Court of Law and/or that the corner points mentioned in lines 3, 4 and 5 above were in conformance with the rules of the Michigan Board of Land Surveyors or by a Decree of a Court of Law; established, re-established, monumented, re-monumented, recovered, found as expressed below:

NOTE: Not more than 4 corners, all in the same town and range, may be recorded on this certificate.

A. Description of original monument and accessories and/or subsequent restoration:

M-12 E 1/4 cor., Sec. 36, T7N-R4E

Wood post placed by J. Wampler, 1822
S44°E 10 lks. (6.60') 7" Sugar
N21°W 17 lks. (11.22') 7" Sugar

Survey by E. Mason, Co. Surveyor, 1866
recorded in Co. Surveyors recorded pgs.
76-77 and BK C pgs. 60-61
Mon. Not Given

N21 1/2°W 26 lks. (17.16') 12" Sugar
S38°E 32 1/2 lks. (21.45') 16" Sugar

Mich. St. Highway Const. Plans 1957 C.S.
No. 76023 C4 sheet 16, Brewer Eng.
Mon. & Refs Not Given

Survey by E.J. McCombs C.P.Co. 1972,
Section Drawing
Mon & Refs Not Given

Surveys by M.L. Vanraemdonck, 1978-79, recorded
in L. 3, pg. 60 & pgs. 144-145 of surveys & L. 2
pg. 143 of cor.
Fnd. iron in mon. box
S15°E 75.40' W. leg road sign
East 34.41' Guard Rail Post
S10°E 63.13' Sta. 46+00 E. side M-13

Unrecorded survey by E.S. Brewer, 1992,
Iron in mon. box on CL M-13 pav't 337.93' South
of CL I-69 Median at inter. curved N. bnd. exit ramp
East 34.4' Guard Rail Post
S15°E 75.4' W. leg road sign

Survey by P.N. Brown, 1993, recorded in L. 6, pgs.
205-206 of surveys.
Fnd. 1/2" iron rod in mon. box
West 27.30' Set tag #20709 in asph. shld.
S75°E 43.18' Set tag #20709 in top guard rail post spacer
N85°E 35.37' Set tag #20709 in top guard rail post spacer
N40°E 45.95' Set tag #20709 in top guard rail post spacer

Survey by N.C. Caldwell, 1993, recorded in L. 2, pg. 870 of cor.
See L. 6, pg. 205-206 for mon. & refs.

B. Description of corner evidence found and/or method applied in restoring or reestablishing corner:

M-12 E 1/4 cor., Sec. 36, T7N-R4E

Fnd. 1/2" iron rod in mon. box per above records, replaced w/a std. 20" Harrison marker as approved by the Shiawassee County Remon. Peer Review Group and is accepted as the best available evidence of the position of the original corner.

C. Description of monument for corner and accessories established to perpetuate locating the position of the corner:


M-12 E 1/4 cor., Sec. 36, T7N-R4E

Fnd. 1/2" iron rod in mon. box per above records, replaced w/a std. 20" Harrison marker as approved by the Shiawassee County Remon. Peer Review Group and is accepted as the best available evidence of the position of the original corner.
West 27.28' Fnd. PK & Tag #20709 in asph. shld.
S75°E 43.21' Fnd. PK & Tag #20709 in top grd. rail post spacer
N85°E 35.36' Fnd. PK & Tag #20709 in top grd. rail post spacer
N40°E 45.91' Fnd. PK & Tag #20709 in top grd. rail post spacer

	A	B	C	D	E	F	G	H	I	J	K	L	M
2	6		5		4		3		2		1		
3													
4	7		8		9		10		11		12		
5													
6	18		17		16		15		14		13		
7													
8	19		20		21		22		23		24		
9													
10	30		29		28		27		26		25		
11													
12	31		32		33		34		35		36		
13													

Signed by *Norman C. Caldwell* Date 10/10/94

Surveyor's Michigan License No. 12018

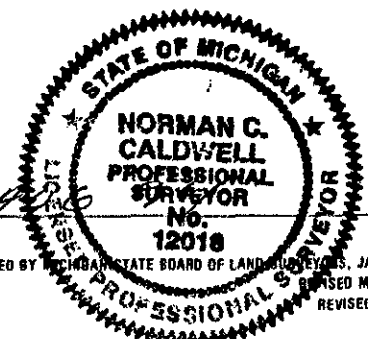

FORM APPROVED BY MICHIGAN STATE BOARD OF LAND SURVEYORS, JAN. 28, 1971
REVISED MAY 14, 1975
REVISED JAN., 1983

LIBER 1 PG 57