

SURVEY &
REMONUMENTATION

SEP 29 1994

COMMISSION

LAND CORNER RECORDATION CERTIFICATE
Filing Requirement of Act 74, Mich. P.A. 1970

RECORDED
94 SEP -6 AM 11:04
REGISTER OF DEEDS
Kaye Smith
SHIAWASSEE COUNTY, MICH.

For corners in

<u>Shiawassee</u> (County)	Located In:	Corner Code #
1. Public Land Survey	T <u>7N</u> R <u>4E</u>	<u>M-13</u>
	T _____ R _____	_____
	T _____ R _____	_____
	T _____ R _____	_____
2. Property Controlling in Section	S _____ T _____ R _____	_____
	S _____ T _____ R _____	_____
3. Miscellaneous Property in Sec.	S _____ T _____ R _____	_____
	S _____ T _____ R _____	_____

Register of Deeds Stamp & File Number

APPROVED

4. Lot No. _____; Recorded Plat _____
5. Private Claims _____

County Remonumentation

Peer Review Group

8/16/94 MLV

I, Norman C. Caldwell, in a field survey on July, 19 94, do hereby certify that under requirements of P.A. 74, Michigan P.A. of 1970, the corner points mentioned in lines 1 and 2 above were in conformance with regulations and rules therefore as required in the current manual of survey instructions of the United States Department of the Interior, Bureau of Land Management or by a decree of a Court of Law and/or that the corner points mentioned in lines 3, 4 and 5 above were in conformance with the rules of the Michigan Board of Land Surveyors or by a Decree of a Court of Law; established, re-established, monumented, re-monumented, recovered, found as expressed below:

NOTE: Not more than 4 corners, all in the same town and range, may be recorded on this certificate.

	A	B	C	D	E	F	G	H	I	J	K	L	M
2	6		5		4		3		2		1		
3													
4	7		8		9		10		11		12		
5													
6	18		17		16		15		14		13		
7													
8	19		20		21		22		23		24		
9													
10	30		29		28		27		26		25		
11													
12	31		32		33		34		35		36		
13													

A. Description of original monument and accessories and/or subsequent restoration:

M-13 Std. cor. Sec. 36, T7N-R4E, & Sec. 31, T7N-R5E

Wood post placed by J. Wampler, 1822
S42°E 23 lks. (15.18') 12" Beech
N67°W 11 lks. (7.26') 7" Cherry

Survey by E.S. Brewer, May 1977, recorded in L. 2, pg. 523-524 of surveys, S.C.R.
Mon. & Refs. Not Given

Survey by E. Mason, Feb. 1866, recorded County Surveyors record pgs. 76-77 also BK C pg. 60-61, S.C.R.
Mon. & Refs. Were Not Given

Unrecorded survey by J.S. Fokens, Oct. 1978
Fnd. 1/2" iron Pipe
N80°E 80.33' N & F in 26" stump
S80°E 95.73' N & F in Power Pole
S75°W 59.02' N & F in Power Pole

Highway Dept. old road plans for County Line Road dated Feb. 1931.
Cor. is 1/2" gas pipe
N33°00'W 42.7' 6" Thornapple
N54°30'E 26.85' Iron post 6' high
N80°45'E 66.8' 12" Hickory
S86°09'E 127.5' from sta. 23+75.5

Survey by P.N. Brown, April 1993, recorded in L. 6, pgs. 605-606 of surveys, S.C.R.
Fnd. 1/2" pipe used in Sec. 6, T6N-R5E
North 7.70' Fnd. newer, galv. - split seam 1/2" i.d. pipe
North 57.58' Fnd. mon.
N15°E 37.57' Fnd. Landmark Tag SE Fc. 6" Elm
N50°E 53.79' Set tag #11192 in NW fc. 6" Hickory
S10°W 33.18' Set tag #11192 in E. fc. 6" Elm
S45°W 58.42' Set tag #11192 NW fc. 6" Elm

Mich. St. Highway R.O.W. plans, dated Jan. 1961
Sec. cor. is 127.5' E. of CL M-13

Survey by N.C. Caldwell, Oct. 1993 recorded in L. 2 pg. 870 of corners.
Fnd. 1/2" pipe - See L. 6, pg. 605-606 of surveys for refs.

B. Description of corner evidence found and/or method applied in restoring or reestablishing corner:

M-13 Std. cor. Sec. 36, T7N-R4E, Sec. 31, T7N-R5E


(See complete report on reverse of this form).

C. Description of monument for corner and accessories established to perpetuate locating the position of the corner:

M-13 Std. cor. Sec. 36, T7N-R4E, Sec. 31, T7N-R5E

Fnd. 6 - 5" diam. rocks around a 4" vit. clay tile w/cinders inside, over an 8" x 12" tall pointed stone. Replaced pointed stone w/a Std. 20" Harrison marker w/stones and clay tile around it as approved by the Shiawassee County Remon. Peer Review Group and is accepted as a careful and faithful perpetuation of the position of the original corner.

North 49.98' Fnd. conc. monument
N35°W 43.16' Set N & T #12018 NE fc. 7" Thornapple
S50°W 62.89' Fnd. N & T (set new N & T #12018 - below)
N. fc. clump of 4 - 6" Elms
South 89.78' Set N & T #12018 W. fc. Power Pole
South 7.60' Fnd. 5/8" rerod

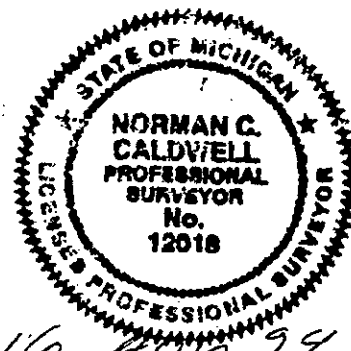

Signed by *Norman C. Caldwell* Date 16 Nov 94

Surveyor's Michigan License No. 12018

FORM APPROVED BY MICHIGAN STATE BOARD OF LAND SURVEYORS, JAN. 28, 1971
REVISED MAY 14, 1975
REVISED JAN., 1983

LIBER 1 PG 49

7526

B. Description of corner evidence found and/or method applied in restoring or reestablishing corner:

M-13 Std. cor. Sec. 36, T7N-R4E, Sec. 31, T7N-R5E


Excavated 8' E-W x 20' N-S x 3' deep (15" below original ground) with a backhoe, searching for reliable evidence of the common corner of T7N-R4 & 5E on Shiawassee-Genesee County Line.

Found 6 - 5" diam. rocks around a 4" vit. clay tile w/cinders inside, over an 8" x 12" tall pointed stone. The stone is 18" below existing road surface, 6" below original ground. The top of the clay tile was flush with original ground, and encircled with the smaller stones. The stone was left in place and a 1" bolt driven alongside for ease of location for placing the Harrison monument.

This is near the "Northern" pipe found flush w/old gravel, 8" below new lime stone surfacing.

No additional evidence could be found to support the "Southern" pipe used by REI.

I believe the stone & tile to be the monument used by Ezra Mason, Shiawassee County Surveyor, 12 & 13 Feb., 1866, and M.B. Sage, Genesee County Surveyor, 11 Oct., 1870 as verified by retracing measurements of the recorded surveys.

 

LIBER 1 PG 50

50 PG 1 LIBER