

NOV 10 1997

COMMISSION

**LAND CORNER RECORDATION CERTIFICATE**  
 Filing Requirement of Act 74, Mich. P.A. 1970

RECORDED

97 OCT 15 PM 12:14

REGISTER OF DEEDS

*Wayne Shambaugh*  
 SHIawassee COUNTY, MICH.

For corners in Shiawassee Located In: Fairfield Twp Corner Code # \_\_\_\_\_  
 (County)

1. Public Land Survey T 8N R 1E D-9  
 T \_\_\_\_\_ R \_\_\_\_\_  
 T \_\_\_\_\_ R \_\_\_\_\_  
 T \_\_\_\_\_ R \_\_\_\_\_

2. Property Controlling S \_\_\_\_\_ T \_\_\_\_\_ R \_\_\_\_\_  
 in Section S \_\_\_\_\_ T \_\_\_\_\_ R \_\_\_\_\_

3. Miscellaneous S \_\_\_\_\_ T \_\_\_\_\_ R \_\_\_\_\_  
 Property in Sec. S \_\_\_\_\_ T \_\_\_\_\_ R \_\_\_\_\_

Register of Deeds Stamp & File Number

4. Lot No. \_\_\_\_\_, Recorded Plat \_\_\_\_\_  
 5. Private Claims \_\_\_\_\_

	A	B	C	D	E	F	G	H	I	J	K	L	M
1													
2	6	5			4	3	2	1					
3													
4	7	8			9	10	11	12					
5													
6	18	17			16	15	14	13					
7													
8	19	20			21	22	23	24					
9													
10	30	29			28	27	26	25					
11													
12	31	32			33	34	35	36					
13													

I, Wendy A. Papineau, in a field survey on June 1997, do hereby certify that under requirements of P.A. 74, Michigan P.A. of 1970, the corner points mentioned in lines 1 and 2 above were in conformance with regulations and rules therefore as required in the current manual of survey instructions of the United States Department of the Interior, Bureau of Land Management or by a decree of a Court of Law and/or that the corner points mentioned in lines 3, 4 and 5 above were in conformance with the rules of the Michigan Board of Land Surveyors or by a Decree of a Court of Law; established, re-established, monumented, re-monumented, recovered, found as expressed below:

NOTE: Not more than 4 corners, all in the same town and range, may be recorded on this certificate.

A. Description of original monument and accessories and/or subsequent restoration:

D-9 Closing Corner, Section 20 and Section 29, T8N-R1E

Wood post placed by R. Thomas, D.S., March 16, 1831  
 N23E 18 lks (11.88') 7" Sugar  
 S25E 30 lks (19.80') 4" Sugar

There are no records that indicate subsequent establishment or use of this position.

B. Description of corner evidence found and/or method applied in restoring or reestablishing corner:

D-9 Closing Corner, Section 20 and Section 29, T8N-R1E

Found no evidence of bearing trees. Calculated a position at the intersection of the Michigan Meridian and the extension of the North line of Section 28 as established by a County Survey by Ezra Mason, 1883, recorded in Shiawassee County Records, 1879-1900, Pgs 110-111, S.C.D.R. We excavated a 2.5' dia. x 3.5' deep hole, found a small 3" x 3/4" flat piece of metal- appears not to be a monument. Found no additional evidence of corner.

There appears to be no conflicting evidence and this position is accepted as a careful and faithful determination of the position of the original corner.

Approved by the Shiawassee County Remonumentation Peer Review Group September 4, 1997

C. Description of monument for corner and accessories established to perpetuate locating the position of the corner:

D-9 Closing Corner, Section 20 and Section 29, T8N-R1E

Placed a standard Harrison monument in a monument box.

S75E 95.88' Set pk w/tag #39096 NE fc P/P  
 N50E 78.54' Set N&T #39096 SE fc 24" Box Elder  
 N45W 49.90' Set N&T #39096 East fc 30" W. Oak  
 S50W 38.69' Set N&T #39096 SE fc 24" S. Maple

**APPROVED**  
 County Remonumentation  
 Peer Review Group  
 NCC  
 10 OCT 97



Signed by Wendy A. Papineau

Date 10-09-97

Surveyor's Michigan License No. 41919

FORM APPROVED BY MICHIGAN STATE BOARD OF LAND SURVEYORS, JAN. 28, 1971

REVISED MAY 14, 1975  
 REVISED JAN., 1983  
 ADAPTED FOR WORD PROCESSING MARCH, 1983

**LIBER 4B PG 206**

BEARINGS ARE BASED ON A PREVIOUS RECONSTRUCTION PROJECT DRAWN THROUGH MAY 1998 BY ROWE ENGINEERING, INC. JOB NO. S-4432 AND ALSO A SOLAR OBSERVATION AT THE NORTH END OF THE 1987 RECONSTRUCTION PROJECT

A PORTION OF


THE

# MICHIGAN MERIDIAN

RETACEMENT AND REMONUMENTATION PROJECT  
FOR  
CLINTON AND SHAWASSEE COUNTIES, MICHIGAN  
MARCH - SEPTEMBER 1997




SHEET 1 OF 2 SHEETS

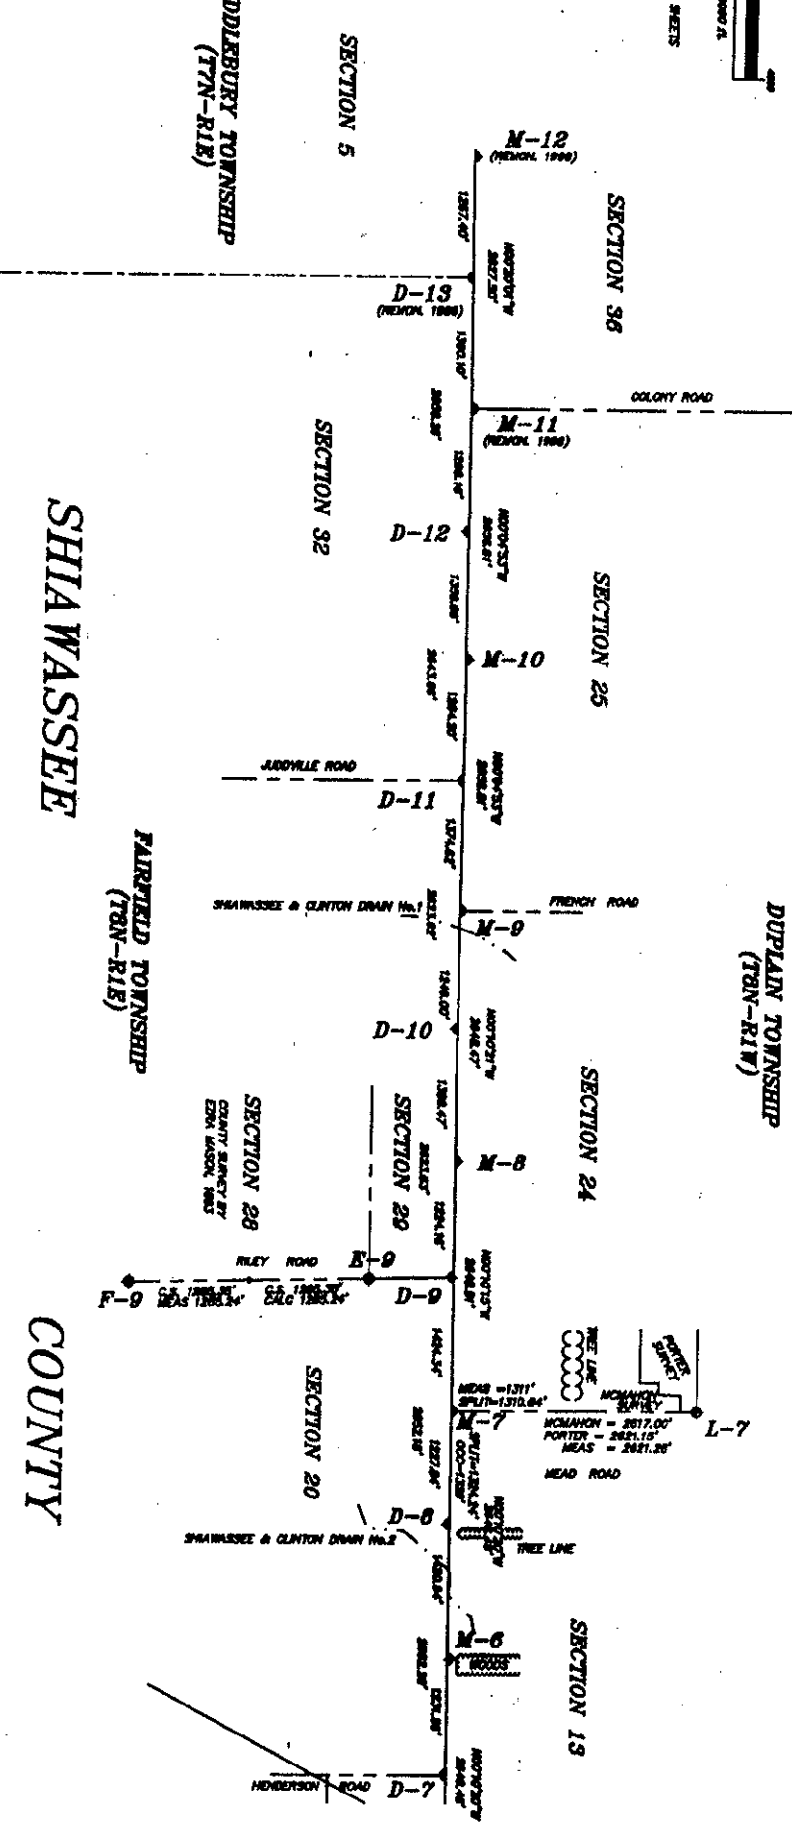

CLINTON

COUNTY

BY  
**ROWE ENGINEERING, INC.**  
112 E. MCARTHUR STREET  
CORUNNA, MI 48837

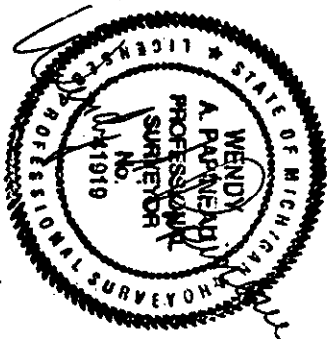

SURVEY &  
REMONUMENTATION  
NOV 10 1997  
COMMISSION