

LAND CORNER RECORDATION CERTIFICATE
Filing Requirement of Act 74, Mich. P.A. 1970

SURVEY &
 REMONUMENTATION

NOV 03 1998

SECTION

For corners in

<u>Shiawassee</u> (County)	Located in:	Corner Code #
1. Public Land Survey	T <u>8N</u> R <u>1E</u>	<u>L-7</u>
	T _____ R _____	_____
	T _____ R _____	_____
	T _____ R _____	_____
2. Property Controlling In Section	S _____ T _____ R _____	_____
	S _____ T _____ R _____	_____
3. Miscellaneous Property in Sec.	S _____ T _____ R _____	_____
	S _____ T _____ R _____	_____
4. Lot No. _____	Recorded Plat _____	
5. Private Claims _____		

**Register of Deeds Stamp
& File Number**

A	B	C	D	E	F	G	H	I	J	K	L	M
2	6	5	4	3	2	1						
3												
4	7	8	9	10	11	12						
5												
6	16	17	18	15	14	13						
7												
8	19	20	21	22	21	24						
9												
10	30	29	28	27	28	25						
11												
12	31	32	33	34	35	36						
13												

I, Mark L. VanRaemdonck, in a field survey on June 16, 1998, do hereby certify that under requirements of P.A. 74, Michigan P.A. of 1970, the corner points mentioned in lines 1 and 2 above were in conformance with regulations and rules therefore as required in the current manual of survey instructions of the United States Department of the Interior, Bureau of Land Management or by a decree of a Court of Law and/or that the corner points mentioned in lines 3, 4 and 5 above were in conformance with the rules of the Michigan Board of Land Surveyors or by a Decree of a Court of Law, established, re-established, monumented, re-monumented, recovered, found as expressed below:

NOTE: Not more than 2 corners, all in the same town and range, may be recorded on this certificate.

A. Description of original monument and accessories and/or subsequent restoration:


- 1.) Original R. Thomas D.S. 1831
 Monument: wood post
 Accessories: Lynn 18 N38°E 15 lks
 Beech 6 S65°W 6
- 2.) Lyman Mason Book E Page 44-45 Dec. 1, 2, 3, 1879
 Monument: Not given
 Accessories: Sugar 12 S70°W 25 1/2
 do 10 N45 1/2W 37 3/4
- 3.) E.F. Joslin County Surveyor Book F, p. 32 Circa 1900
 Monument: Searched for and found 1/4 post, though witnesses were gone. Monument was a piece of Hammered boulder about 15" of nearly square cross section about 6" on a side. Also an iron stake on S. side of stone.
 Accessories: None given
- 4.) F.A. Gould his field book 7, p. 46 7/24/1922
 Monument: Piece of hammered field boulder about 15" nearly square cross section about 6" on side. Also an iron stake on S. side of stone.
 Accessories: None given.
- 5.) John F. Quine field book 19, p. 46 10/21/1975
 Monument: Found an iron railroad coupling pin 1 1/2" x 12", flange 3" below top, 3" deep and bent to West. Dug on N side but did not find stone. Straightened pin. Drove to 6" deep and magnetized.
 Accessories: Telephone pole N65°W 28.15'
 Power pole N45°E 89.0'
 Elm stump 35" South 37.3'
 Power pole S10°W 68.7'
 Stake is on centerline of gravel road.

B. Description of corner evidence found and/or method applied in restoring or re-establishing corner:
 Found 1 1/2" dia. solid steel rod in centerline of gravel road at location referenced in No. 5 above. Found no conflicting evidence. Accepted this location as the careful and faithful perpetuation of the original corner position.

C. Description of monument for corner and accessories to perpetuate locating the position of the corner:
 Replaced the 1 1/2" solid steel rod with a standard Shiawassee County Harrison Marker Monument stamped "REMON P.S. 24622". The monument is witnessed by the following accessories:
 S70°E 57.21' Set N&T NE face 12" W. Ash
 S60°W 52.94' Set N&T N. face 10" Linden (W. trunk of clump)
 N60°W 28.05' Set N&T NE face util. pole
 N25°W 25.59' Set N&T E. face 10" Hickory (SE trunk of clump)

Signed by Mark L. VanRaemdonck
 Surveyor's Michigan License No. 24622

Date SEPT 2, 1998

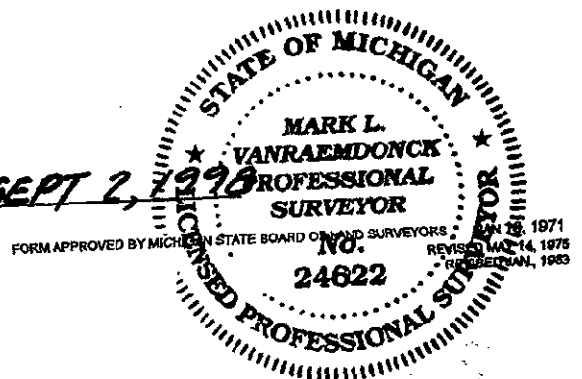

Kays Grubba - Shiawassee Co.

REMON

3007705

Page: 1 of 1
 10/27/1998 03:22P

Lb-1 Pg-258