

LAND CORNER RECORDATION CERTIFICATE
Filing Requirement of Act 74, Mich. P.A. 1970

For corners in

Shiawassee
(County)

Located in:

Corner Code #

1. Public Land Survey

T 8N R 1E M-7

2. Property Controlling
In Section

S T R

3. Miscellaneous
Property in Sec.

S T R

4. Lot No. _____

S T R

5. Private Claims _____

Recorded Plat _____

SURVEY &
REMONUMENTATION

NOV 03 1998

SECTION

Register of Deeds Stamp
& File Number

I, Mark L. VanRaemdonck, in a field survey on June 16, 1998, do hereby certify that under requirements of P.A. 74, Michigan P.A. of 1970, the corner points mentioned in lines 1 and 2 above were in conformance with regulations and rules therefore as required in the current manual of survey instructions of the United States Department of the Interior, Bureau of Land Management or by a decree of a Court of Law and/or that the corner points mentioned in lines 3, 4 and 5 above were in conformance with the rules of the Michigan Board of Land Surveyors or by a Decree of a Court of Law, established, re-established, monumented, re-monumented, recovered, found as expressed below:

NOTE: Not more than 2 corners, all in the same town and range, may be recorded on this certificate.

A. Description of original monument and accessories and/or subsequent restoration:

- 1.) Original Robert Clark, Jr., D.S. 227/1831
 Monument: wood post
 Accessories: Tamarack 11 N38 1/2°E 22
 Maple 8 S51°W 33
- 2.) Lyman Mason Book E Page 44-45 Dec. 1, 2, 3, 1879
 Monument: Not given
 Accessories: None given
- 3.) E.F. Joslin County Surveyor Book T (now CR-67), p. 97 11/16-18/04
 Monument: Large stake a piece of buggy tire and bricks at corner. Found old stake.
 Accessories: None given
- 4.) F.A. Gould County Surveyor Book 7, p. 46 7/24/1922
 Monument: Dug small hole. Found stake 4" Oak. Placed Ford muffler on top of stake.
 Accessories: None given.
- 5.) Mark VanRaemdonck L.C.R.C. recorded Liber 3, page 29, 7/23/98
 Monument: 1/2" dia. rerod, 18" long with yellow plastic cap stamped "Landmark P.S. 24622"
 Accessories: South 24.5' Centerline drain
 S80°W 76.50' Util. pole
 N10°E 143.00' SW corner building
 N30°W 158.00' SE corner building

B. Description of corner evidence found and/or method applied in restoring or re-establishing corner:
 Found 1/2" rerod & cap #24622. Location was re-established by retracing Mason survey referenced in No. 2 above. This location is on the centerline of Henderson Road extended on a tree line to the South.
 Found no conflicting evidence. Accepted this location as the careful and faithful re-establishment of the original corner position based on the best available evidence.

C. Description of monument for corner and accessories to perpetuate locating the position of the corner:
 Replaced the rerod and cap with a standard Shiawassee County Harrison Marker Monument stamped "REMON P.S. 24622". The monument is witnessed by the following accessories:


- South 24.5' Centerline drain
- S80°W 76.20' N&T #24622 in N face util. pole
- N10°E 143.00' SW corner building
- N30°W 158.00' SE corner building
- S89°41'11"W 2764.10' Harrison Marker at L-7
- S01°03'19"E 2629.50' Harrison Marker at M-8

Signed by Mark L. VanRaemdonck

Date SEPT. 24, 1998

Surveyor's Michigan License No. 24622

FORM APPROVED BY MICHIGAN STATE BOARD OF LAND SURVEYORS JAN 18, 1971
 REVISED MAY 14, 1975
 REVISED JAN, 1983

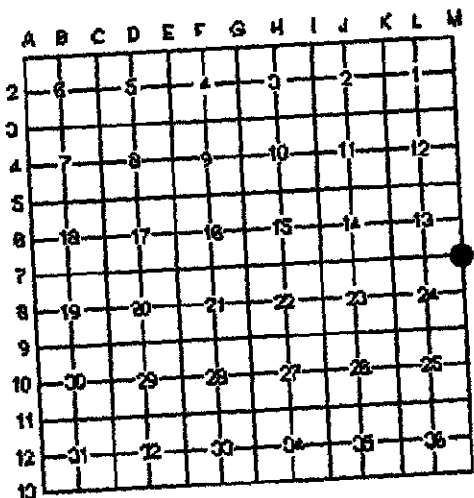

APPROVED

County Remonumentation
Peer Review Group

NCC 7 OCT 98



3007707
 Page: 1 of 1
 10/27/1998 03:22P
 Lb-1 Pg-260