

LAND CORNER RECORDATION CERTIFICATE
Filing Requirement of Act 74, Mich. P.A. 1970

For corners in

| | | |
|---------------------------------------|-------------------------|---------------|
| <u>Shiawassee</u> (County) | Located in: | Corner Code # |
| 1. Public Land Survey | T <u>8N</u> R <u>1E</u> | <u>M-8</u> |
| | T _____ R _____ | _____ |
| | T _____ R _____ | _____ |
| | T _____ R _____ | _____ |
| 2. Property Controlling In Section | S _____ T _____ R _____ | _____ |
| | S _____ T _____ R _____ | _____ |
| 3. Miscellaneous Property in Sec. | S _____ T _____ R _____ | _____ |
| | S _____ T _____ R _____ | _____ |
| 4. Lot No. _____ | Recorded Plat _____ | |
| 5. Private Claims _____ | | |

SURVEY &
REMONUMENTATION


NOV 03 1998

SECTION

**Register of Deeds Stamp
& File Number**

I, Mark L. VanRaemdonck, in a field survey on August 19, 1998, do hereby certify that under requirements of P.A. 74, Michigan P.A. of 1970, the corner points mentioned in lines 1 and 2 above were in conformance with regulations and rules therefore as required in the current manual of survey instructions of the United States Department of the Interior, Bureau of Land Management or by a decree of a Court of Law and/or that the corner points mentioned in lines 3, 4 and 5 above were in conformance with the rules of the Michigan Board of Land Surveyors or by a Decree of a Court of Law, established, re-established, monumented, re-monumented, recovered, found as expressed below:

NOTE: Not more than 2 corners, all in the same town and range, may be recorded on this certificate.

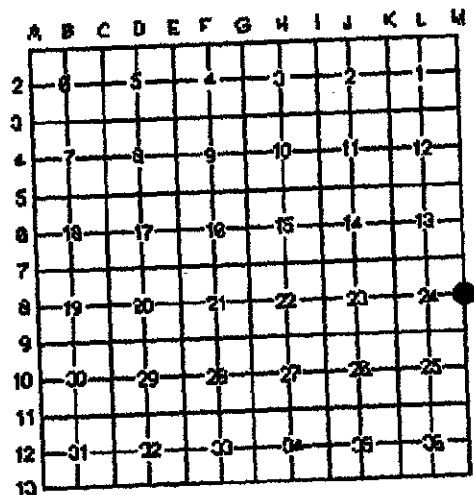

APPROVED

County Remonumentation
Peer Review Group

NCC 700T 98

A. Description of original monument and accessories and/or subsequent restoration:

1. Original Robert Clark, Jr. February 27, 1831
Monument: Wood Stake
Accessories: Beech 8 S20°E 14LKS
do 20 S60°W 15LKS
2. Lyman Mason, County Surveyor, County Surveyor's Records, Book E, page 44-46, December 1, 2 & 3, 1879
Monument: Not given
Accessories: Double S. Oak 14 N58½°E 107

B. Description of corner evidence found and/or method applied in restoring or re-establishing corner:

Found no evidence of original monument or accessories. Found no evidence of subsequent restoration. At the interior ¼ corner of Section 24, (L-8) found 3/4 inch pipe as described by John Quine, in County Surveyor Record Book G, dated 6-23-87, Quine states he found a large stone with small ones around it. L. Mason's survey of 1879 calls for a large stone with small ones around it at the center of Section 24. I measured East from the 3/4" pipe to the North and South ½ line fence. This distance was 1374.5 feet. Mason's survey shows this distance to be 20.82 chains or 1374.12 feet. To re-establish the position of corner M-8, I extended the line between corner K-8 and the 3/4" pipe at the center of Section 24, East at a distance of 2749.00 feet (twice the distance between the 3/4" pipe and the North and South ½ line fence). I found no conflicting evidence at this location. Distance to corner M-7 is 2635.15 feet and distance to corner M-7 is 2634.05 feet. I accepted this location as the careful and faithful re-establishment of the original corner position based on the best available evidence.



C. Description of monument for corner and accessories to perpetuate locating the position of the corner:

At the location described above, I installed as standard Shiawassee County, Harrison Marker Monument, stamped "Remon P.S. 24622" and witnessed by the following accessories:

- | | | |
|-------|--------|----------------------------|
| N05°E | 27.81' | Set N&T in W face 24" Oak |
| S70°W | 63.32' | Set N&T N face 24" Hickory |
| N20°W | 44.88' | Set N&T E face 8" Ash |
| S65°E | 38.89' | Set N&T N face util. pole |

Signed by Mark L. VanRaemdonck
 Surveyor's Michigan License No. 24622

Date SEPT. 11, 1998

FORM APPROVED BY MICHIGAN STATE BOARD OF LAND SURVEYORS JAN 18, 1971
 REVISED MAY 14, 1975
 REVISED JAN., 1983