

**LAND CORNER RECORDATION CERTIFICATE**  
 Filing Requirement of Act 74, Mich. P.A. 1970

For corners in

Shiawassee  
(County)

Located in:

Corner Code #

1. Public Land Survey

T 8N R 1E M-10

2. Property Controlling In Section

S      T      R     

3. Miscellaneous Property in Sec.

S      T      R     

4. Lot No. \_\_\_\_\_

S      T      R     

5. Private Claims \_\_\_\_\_

Recorded Plat \_\_\_\_\_

SURVEY &  
REMONUMENTATION

NOV 03 1998

SECTION

Register of Deeds Stamp  
& File Number

I, Mark L. VanRaemdonck, in a field survey on June 16, 1998, do hereby certify that under requirements of P.A. 74, Michigan P.A. of 1970, the corner points mentioned in lines 1 and 2 above were in conformance with regulations and rules therefore as required in the current manual of survey instructions of the United States Department of the Interior, Bureau of Land Management or by a decree of a Court of Law and/or that the corner points mentioned in lines 3, 4 and 5 above were in conformance with the rules of the Michigan Board of Land Surveyors or by a Decree of a Court of Law, established, re-established, monumented, re-monumented, recovered, found as expressed below:

**NOTE: Not more than 2 corners, all in the same town and range, may be recorded on this certificate.**

A. Description of original monument and accessories and/or subsequent restoration:

1. Original Robert Clark, Jr., D.S. February 27, 1831

Monument: Wood Stake  
 Accessories: Sugar 16 S89°E 3 1/2 LKS  
 Beech 18 N21°W 37 LKS

2. Ezra Mason, County Surveyor, County Surveyor's Records, Book C, page 210, February 24 & 25, 1871

Monument: Not given  
 Accessories: Aspen 4 S55 1/2°W 56  
 Elm 8 N24°E 187

3. John Quine, LCRC, recorded Liber 2, page 11, July 26, 1976

Monument: Found 1" E & W by 4" N & S rusty solid iron bar 18" deep and badly bent to East. Set 1/2" by 18" solid iron reinforcing rod on West side of old stake at estimated original location.  
 Accessories: Power pole W 92.3  
 Oak 30" N20°E 102.6'  
 Mailbox post N45°E 20.6'  
 Property corner iron S45°E 48.1'  
 Tele. & power pole S40°E 38.9'  
 Cen. line N end 12" conc. culv. S25°E 40.5'  
 Cen. line gravel road East 1.0'

(continued on reverse)

B. Description of corner evidence found and/or method applied in restoring or re-establishing corner:  
 Found rerod with cap stamped "JFQ 10704" also found old single bit axe head on East side of rerod. (1" x 4" rusty solid iron bar) the rerod was verified by the referenced in No. 3 above. Found no evidence of original monument or accessories. I accepted this location as the original corner position based on the best available evidence. Found no conflicting evidence.

C. Description of monument for corner and accessories to perpetuate locating the position of the corner:  
 I replaced the rerod and cap with a standard Shiawassee County Harrison Marker Monument, stamped "Remon PS 24622" and witnessed by the following accessories:

West	92.30'	Fnd Nail in N face util. pole
N20°E	101.75'	Fnd. N&T 24622 in W face 30" Oak
N50°E	19.04'	SW cor. 4x4 mail box post
S40°E	38.70'	Cen. W face tele. pole
S35°E	40.32'	Top cen. N end 12" conc. culv.
South	33.53'	Rerod, bent top 3" being the W 1/2 corner, Section 30, T8N-R2W, tree line East


Signed by Mark L. VanRaemdonck

Surveyor's Michigan License No. 24622

Date SEPT. 15, 1998

FORM APPROVED BY MICHIGAN STATE BOARD OF LAND SURVEYORS

JAN 16, 1971  
 REVISED MAY 14, 1978  
 REVISED JAN. 1985

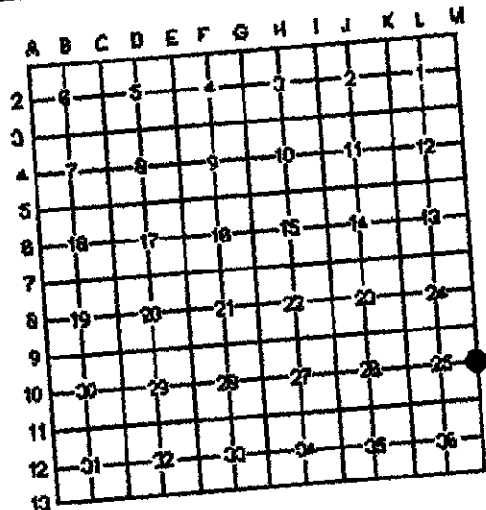

**APPROVED**

County Remonumentation  
Peer Review Group

*MLC 7 Oct 98*



3087715  
 Page: 1 of 2  
 10/27/1998 03:22P  
 Lb-1 Pa-268

Kaye Grubba - Shiawassee Co. REMON

A. Description of original monument and accessories and/or subsequent restoration:  
(continued from front)

4. John Quine, Certified Survey, Recorded Liber 2.  
Monument and accessories refers to LCRC, recorded Liber 2, page 11
5. John Quine, unrecorded survey, dated July 15, 1978  
Monument and accessories refers to LCRC, recorded Liber 2, page 11
6. John Quine, certified survey, recorded Liber 6, page 885, July 8, 1994  
Monument: Found  $\frac{1}{2}$ " x 18" iron rerod 6" deep over 1" x 4" iron bar 18" deep.  
Accessories: refers to LCRC, recorded Liber 2, page 11

SURVEY &  
REMONUMENTATION

NOV 03 1998

SECTION



3007715  
Page: 2 of 2  
10/27/1998 03:22P