

APR 08 1996

LAND CORNER RECORDATION CERTIFICATE
Filing Requirement of Act 74, Mich. P.A. 1970

For corners in **COMMISSION**

Shiawassee Located in: _____ Corner Code # _____
(County)

1. Public Land Survey T 8N. R 1E _____ (M-11)
T _____ R _____
T _____ R _____
T _____ R _____

2. Property Controlling S _____ T _____ R _____
in Section S _____ T _____ R _____

3. Miscellaneous S _____ T _____ R _____
Property in Sec. S _____ T _____ R _____

4. Lot No. _____, Recorded Plat _____

5. Private Claims _____

RECORDED
95 NOV 22 PM 1:19
REGISTER OF DEEDS
Raye Shamba
SHIawassee COUNTY, MICH.
Register of Deeds Stamp & File Number

	A	B	C	D	E	F	G	H	I	J	K	L	M
2	6		5		4		3		2		1		
3													
4	7		8		9		10		11		12		
5													
6	18		17		16		15		14		13		
7													
8	19		20		21		22		23		24		
9													
10	30		29		28		27		26		25		
11													
12	31		32		33		34		35		36		
13													

I, Mark L. VanRaemdonck, in a field survey on October 12, 1995, do hereby certify that under requirements of P.A. 74, Michigan P.A. of 1970, the corner points mentioned in lines 1 and 2 above were in conformance with regulations and rules therefore as required in the current manual of survey instructions of the United States Department of the Interior, Bureau of Land Management or by a decree of a Court of Law and/or that the current points mentioned in lines 3, 4 and 5 above were in conformance with the rules of the Michigan Board of Land Surveyors or by a Decree of a Court of Law; established, re-established, monumented, re-monumented, recovered, found as expressed below:

NOTE: Not more than 4 corners, all in the same town and range, may be recorded on this certificate.

A. Description of original monument and accessories and/or subsequent restoration:

- Original: Joseph Wampler, D.S.
Monument: Wood post
Accessories: Beech 8 S6½°W 26 lks
Sugar 6 N30°E 23 lks
- J. Quine, L.C.R.C. recorded Liber 2, page 11, 7/21/76.
Monument: ½" x 18" rerod with cap "JFQ RLS 10704"
Accessories: Oak 40" N25°E 99.5'
Walnut 18" N45°W 36.2'
4 way trans. pole N60°W 50.2'
NW cor. of fnd. of add. to church S45°W 98.5'

- NE cor. of fnd. main part of church S32°W 90.0'
- Power pole S30°W 72.3'
- NE cor. 6' sq. conc. catch basin S10°W 90.3'
- Centerline E. end 18" CMP outlet S15°E 95.2'
- Painted centerline of Juddville Road on "S" curve South 25.4'
- Road name sign post N75°E 27.3'

B. Description of corner evidence found and/or method applied in restoring or reestablishing corner:


Found ½" rerod as referenced in no. 2 above. Found no conflicting evidence. Excavation for Harrison Marker provided no further evidence. Accepted this position as the careful and faithful re-establishment of the corner based on the best available evidence.

C. Description of monument for corner and accessories to perpetuate locating the position of the corner:

Replaced ½" rerod with standard Harrison Marker stamped "REMON 24622" and witnessed by the following accessories:
N70°E 52.07' Set N&T S. face utl. pole
N70°W 47.96' Set N&T S. face utl. pole
S25°W 72.46' Set N&T E. face utl. pole
S05°W 90.37' NE corner conc. drainage structure

APPROVED

County Remonumentation
Peer Review Group

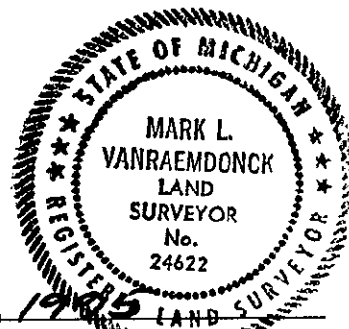

Signed by Mark L. VanRaemdonck Date Nov. 16, 1995
OCT 24, 1995 MLV

Surveyor's Michigan License No. 24622