

APR 08 1996

COMMISSION

LAND CORNER RECORDATION CERTIFICATE
Filing Requirement of Act 74, Mich. P.A. 1970

For corners in

Shiawassee Located in: _____ Corner Code # _____
(County)

1. Public Land Survey T 8N R 1E (M-12)
T _____ R _____
T _____ R _____
T _____ R _____

2. Property Controlling S _____ T _____ R _____
In Section S _____ T _____ R _____

3. Miscellaneous S _____ T _____ R _____
Property in Sec. S _____ T _____ R _____

4. Lot No. _____ Recorded Plat _____

5. Private Claims _____

RECORDED
95 NOV 22 PM 1:18
REGISTER OF DEEDS
Spay
SHIWAASSEE COUNTY, MICH.
Register of Deeds Stamp & File Number

| A | B | C | D | E | F | G | H | I | J | K | L | M |
|----|----|----|----|----|----|----|---|---|---|---|---|---|
| 2 | 6 | 5 | 4 | 3 | 2 | 1 | | | | | | |
| 3 | | | | | | | | | | | | |
| 4 | 7 | 8 | 9 | 10 | 11 | 12 | | | | | | |
| 5 | | | | | | | | | | | | |
| 6 | 18 | 17 | 16 | 15 | 14 | 13 | | | | | | |
| 7 | | | | | | | | | | | | |
| 8 | 19 | 20 | 21 | 22 | 23 | 24 | | | | | | |
| 9 | | | | | | | | | | | | |
| 10 | 30 | 29 | 28 | 27 | 26 | 25 | | | | | | |
| 11 | | | | | | | | | | | | |
| 12 | 31 | 32 | 33 | 34 | 35 | 36 | | | | | | |
| 13 | | | | | | | | | | | | |

I, Mark L. VanRaemdonck, in a field survey on October 19, 1995, do hereby certify that under requirements of P.A. 74, Michigan P.A. of 1970, the corner points mentioned in lines 1 and 2 above were in conformance with regulations and rules therefore as required in the current manual of survey instructions of the United States Department of the Interior, Bureau of Land Management or by a decree of a Court of Law and/or that the current points mentioned in lines 3, 4 and 5 above were in conformance with the rules of the Michigan Board of Land Surveyors or by a Decree of a Court of Law; established, re-established, monumented, re-monumented, recovered, found as expressed below:

NOTE: Not more than 4 corners, all in the same town and range, may be recorded on this certificate.

A. Description of original monument and accessories and/or subsequent restoration:

- Original: Joseph Wampler, D.S.
Monument: Wood post
Accessories: W. Oak 36 S47°W 25
do 6 N44°E 10
- In Book C of Surveys on page 216, Ezra Mason shows that the West 1/4 corner of Section 31, T8N-R2E is 0.43 chains (28.38') South of the East 1/4 corner of Section 36, T8N-R1E.


B. Description of corner evidence found and/or method applied in restoring or reestablishing corner:

Found the West 1/4 corner of Section 31, T8N-R2E, as per L.C.R.C. by J. Quine, recorded Liber 2, page 14, re-established this corner location 28.38 feet North of the West 1/4 corner of Section 31 on line between said West 1/4 corner and the Northeast corner of Section 36, T8N-R2E. This location is 0.65 feet South of the split of the distance between Northeast and Southeast corners. Found no conflicting evidence. Excavation for Harrison Marker provided no further evidence. Accepted this position as the careful and faithful re-establishment of the corner location based on the best available evidence.

C. Description of monument for corner and accessories to perpetuate locating the position of the corner:

Installed Harrison Marker stamped "Ramon 24622" at the above described location. The marker is witnessed by the following accessories:
S45°E 77.00' Set N&T #24622 NE face 36" Oak
N80°E 27.11' Set N&T S. face 8" Ash
N20°W 57.53' Set N&T #24622 in E. face S. trunk 12" Maple
S30°W 31.81' Set N&T #24622 in NW face 24" Maple

APPROVED
County Remonumentation
Peer Review Group

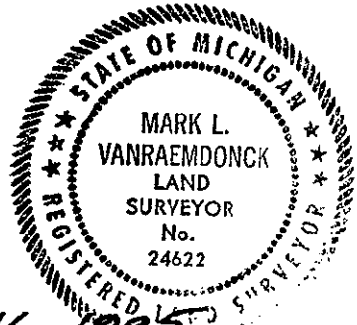

Signed by Mark L. VanRaemdonck Date Nov. 16, 1995
Surveyor's Michigan License No. 24622

FORM APPROVED BY MICHIGAN STATE BOARD OF LAND SURVEYORS JAN 18, 1971
REVISED MAY 14, 1975
REVISED JAN., 1983

LIBER 1R PG 120