

LAND CORNER RECORDATION CERTIFICATE
Filing Requirement of Act 74, Mich. P.A. 1970

con 1

For corners in
Shiawassee SECTION
(County)

Located in:

Corner Code #




3026128
Page: 1 of 1
10/05/1999 02:19P
L-1 P-321

- 1. Public Land Survey T 8N R 2E
- 2. Property Controlling In Section S T R
- 3. Miscellaneous Property in Sec. S T R
- 4. Lot No. S T R
- 5. Private Claims _____ Recorded Plat _____

Register of Deeds Stamp & File Number

I, Mark L. VanRaemdonck, in a field survey on February 15, 1999, do hereby certify that under requirements of P.A. 74, Michigan P.A. of 1970, the corner points mentioned in lines 1 and 2 above were in conformance with regulations and rules therefore as required in the current manual of survey instructions of the United States Department of the Interior, Bureau of Land Management or by a decree of a Court of Law and/or that the corner points mentioned in lines 3, 4 and 5 above were in conformance with the rules of the Michigan Board of Land Surveyors or by a Decree of a Court of Law; established, re-established, monumented, re-monumented, recovered, found as expressed below:

NOTE: Not more than 2 corners, all in the same town and range, may be recorded on this certificate.

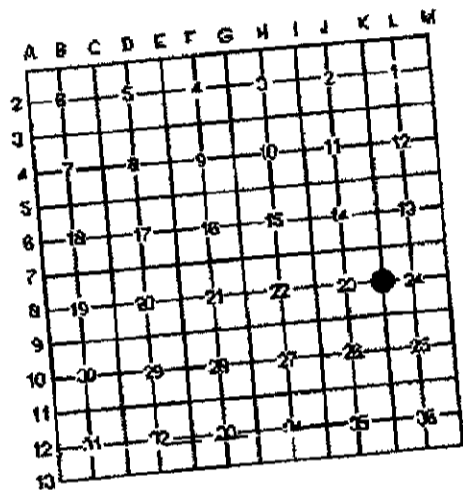

- A. Description of original monument and accessories and/or subsequent restoration:
1. Original: William Brookfield, D.S. 1823.
Mon: Wood post
Accessories: Beech 12 S41/2°E 10
DO 10 N25°E 20
 2. E.L. Mason, County Surveyor, County Surveyor's Book B, page 84 (no date)
Breakdown of Section 24, T8N-R2E.
No monument or accessories given.
 3. Ezra Mason, County Surveyor, County Surveyor's Book C, page 154, Book A, page 24.
Breakdown of Section 24, T8N-R2E.
December 22 and 23, 1868.
No monument or accessories given.
 4. County Surveyor's Book F, page 262.
Mon: Not given.
Accessories: W. Oak 40° N34°E 35 3/4 L.
Beech 9° S06°E 9 L.
 5. O.M. Elliot, County Surveyor, 9-22-1969, Field Book 33, page 34.
Mon: Not given.
Accessories: Maple 10° S40°W 41.2
Walnut 16° S60°E 72
SW cor. Barn 7 89.3'
 6. Mark L. VanRaemdonck, L.C.R.C., Recorded Liber 2, page 499, January 29, 1988.
Mon: Found RR spike
Accessories: S20°W 89.35' P.K. NE face 14" Maple
S40°W 41.26' P.K. NE face 12" Maple
N80°E 89.73' Top conc. & stone fig. @ SW face fig. Barn
S80°E 137.68' NW cor. Conc. fig. Farm out bldg.
 7. Mark L. VanRaemdonck, Certified Survey, Recorded Liber 6, page 257, August 13, 1992.
Mon. and Accessories same as No. 6 above.
 8. Mark L. VanRaemdonck, Certified Survey, Recorded Liber 7, page 839, March 6, 1997.
Mon. and Accessories same as No. 6 above.
 9. Mark L. VanRaemdonck, unrecorded survey, January 20, 1997.
Mon. and Accessories same as No. 6 above.

APPROVED

County Remonumentation
Peer Review Group / OCT 29
NCC



- B. Description of corner evidence found and/or method applied in restoring or re-establishing corner:
Found railroad spike as referenced in No. 6, 7, 8 and 9 above. Also, Elliot's ties, No. 5 above, fit this location. Found no conflicting evidence. Accepted this location as the original corner position based on the best available evidence.
- C. Description of monument for corner and accessories to perpetuate locating the position of the corner:
Replaced RR spike with a standard Shiawassee County Harrison marker monument in a monument box. The monument is stamped "REMON P.S. 24622" and is witnessed by the following accessories:

- S20°W 41.59' Set N&T E. face 14" Maple
- S10°W 90.01' Set N&T E. face 14" Maple
- East 8.96' Set R&C #24622
- N25°W 56.38' R&C #24622

Signed by Mark L. VanRaemdonck
Surveyor's Michigan License No. 24622

Date SEPT 27, 1999