

APR 08 1996

LAND CORNER RECORDATION CERTIFICATE
Filing Requirement of Act 74, Mich. P.A. 1970

For corners in

COMMISSION

Shiawassee
(County)

Located in:

Corner Code #

RECORDED

95 NOV 22 PM 1:20

REGISTER OF DEEDS

Hayes
SHIawassee COUNTY, MICH.

Register of Deeds Stamp & File Number

- 1. Public Land Survey T 8N R 2E (L-13)
T _____ R _____
T _____ R _____
T _____ R _____
- 2. Property Controlling S _____ T _____ R _____
in Section S _____ T _____ R _____
- 3. Miscellaneous S _____ T _____ R _____
Property in Sec. S _____ T _____ R _____
- 4. Lot No. _____, Recorded Plat _____
- 5. Private Claims _____

I, Mark L. VanRaemdonck, in a field survey on October 18, 1995, do hereby certify that under requirements of P.A. 74, Michigan P.A. of 1970, the corner points mentioned in lines 1 and 2 above were in conformance with regulations and rules therefore as required in the current manual of survey instructions of the United States Department of the Interior, Bureau of Land Management or by a decree of a Court of Law and/or that the current points mentioned in lines 3, 4 and 5 above were in conformance with the rules of the Michigan Board of Land Surveyors or by a Decree of a Court of Law; established, re-established, monumented, re-monumented, recovered, found as expressed below:

NOTE: Not more than 4 corners, all in the same town and range, may be recorded on this certificate.

A. Description of original monument and accessories and/or subsequent restoration:

- 1.) Original: Joseph Wampler, D.S.
Monument: Wood post
Accessories: W. Oak 30 S64°E 34 lks
Ironwood 7 N61°W 8 lks
- 2.) C.E. Smith, M.D.O.T., July 1962
Monument: 1/2" Iron pipe
Accessories: 14" Maple S00°E 65.35'
30" Maple S65°E 65.65'
32" Oak S60°W 63.22'
P. Pole S55°E 32.11'
- 3.) J.F. Quine, L.C.R.C. recorded Liber 1, page 521, 3/25/75
Monument: Not given.
Accessories: None given. Refers to plans on file.
- 4.) M. VanRaemdonck, Survey recorded Liber 5, page 254, 4/27/89.
Monument: Rerod & cap #24622 in Monument Box
Accessories: S50°E 32.12' Spike & washer in W. face u/p
East 22.63' Rerod & cap #20709
South 44.10' Cen. catch basin grate
West 24.90' Centerline asphalt
N30°E 33.60' S. edge road sign post
- 5.) N.C. Caldwell, Survey recorded Liber 5, page 551, 01/02/90.
Monument: Rerod & cap #24622 in Monument Box
Accessories: Same as no. 4 above.

	A	B	C	D	E	F	G	H	I	J	K	L	M
2	6		5		4		3		2		1		
3													
4	7		8		9		10		11		12		
5													
6	18		17		16		15		14		13		
7													
8	19		20		21		22		23		24		
9													
10	30		29		28		27		26		25		
11													
12	31		32		33		34		35		36		
13													


B. Description of corner evidence found and/or method applied in restoring or reestablishing corner:

Found rerod & cap #24622 in Monument Box as referenced in no. 4 above. One reference (P. Pole S55°E 32.11) remained from no. 2 above. Found no conflicting evidence (10/03/95 MLV & BL2). Excavation for Harrison Marker provided no further evidence. Accepted this corner location as the best available evidence.

C. Description of monument for corner and accessories to perpetuate locating the position of the corner:

Replaced rerod & cap with standard Harrison Marker stamped "REMON 24622" and witnessed by the following accessories:
S60°E 32.79' M.D.O.T. N&T in NE face utl. pole
N50°E 35.16' S. edge road name and stop sign post
East 22.58' Rerod & cap in Monument Box (N 1/4 corner Section 1, T7N-R2E)
South 44.00' Top cen. catch basin grate
S55°E 75.11' NW cor. house foundation

APPROVED
County Remonumentation
Date Review Group

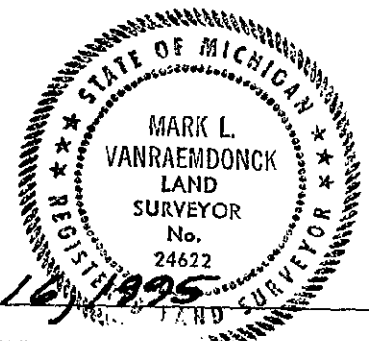

Signed by

Mark L. VanRaemdonck

Date

Nov. 10, 1995

Surveyor's Michigan License No. 24622

FORM APPROVED BY MICHIGAN STATE BOARD OF LAND SURVEYORS JAN 18, 1971
REVISED MAY 14, 1975
REVISED JAN., 1983

LIBER 1R PG 135