

For corners in Shiawassee County APR 08 1996 Located In:

Corner Code #

COMMISSION

ENT

- 1. Public Land Survey T 8 N R 3 E K-13
2. Property Controlling in Section S T R
3. Miscellaneous Property in Sec. S T R

RECORDED

95 SEP -5 PM 1:48

REGISTER OF DEEDS

Spay Shubia

Register of Deeds Stamp & File Number

- 4. Lot No. Recorded Plat
5. Private Claims

I, Norman C. Caldwell, in a field survey on May 23, 1995, do hereby certify that under requirements of P.A. 74, Michigan P.A. of 1970, the corner points mentioned in lines 1 and 2 above were in conformance with regulations and rules therefore as required in the current manual of survey instructions of the United States Department of the Interior, Bureau of Land Management or by a decree of a Court of Law and/or that the corner points mentioned in lines 3, 4 and 5 above were in conformance with the rules of the Michigan Board of Land Surveyors or by a Decree of a Court of Law; established, re-established, monumented, re-monumented, recovered, found as expressed below:

NOTE: Not more than 4 corners, all in the same town and range, may be recorded on this certificate.

A. Description of original monument and accessories and/or subsequent restoration:

K-13 Post placed by J. Wampler, 1822 N70°E 21 lks. (13.86') 12" birch West 11 lks. (7.26') 20" elm

Survey by L. Mason recorded Co. Surveyors Records May 20-22, 1878 N13° 25'E 122 lks. (80.52') 5" S. Maple

Survey by Rowe Engineering Inc. 5/27/73 L 2 P 375 Found "T" iron S40°W 61.80' P.K. & Wash. in 36" oak N45°E 45.90' " " 24" oak N30°E 69.35' " " 24" oak

Survey by D.T. Rowe L.S. 11192 10/2/73 Recorded Oct. 11, 1973, L1, p508 Fnd "T" iron S40°W 61.80' P.K. & Wash. in 36" oak N45°E 45.90' " " 24" oak N30°E 69.35' " " 24" oak

L.C.R.C. by D.T. Rowe L.S. 11192 Sep. 27, 1973 Recorded Oct. 25, 1977, L2, p64 Set "T" iron S40°W 61.80' P.K. & Wash. in 36" oak N45°E 45.90' " " 24" oak N30°E 69.35' " " 24" elm

L.C.R.C. by J.F. Quine L.S. 10704 Dec. 21, 1993 recorded Jan. 19, 1994, L2, p883-884 Found 6"x8"x10" stone, 15" deep, over ring of broken red vitrified tile 24" deep. Placed 1/2"x24" rebar at this position.

S40°W 68.6' 2" oak (old B.T.) S75°W 60.9' N.E. corner conc. HDWL. N75°W 57.6' S.E. " " " N50°W 26.3' S.W. " " " N45°W 33.25' N.E. " " " N40°E 38.6' N.W. " " " N55°E 30.4' S.W. " " " N65°E 40.30' 36" oak S45°E 32.3' road sign post S35°E 35.8' 1/2" bar w/10704 cap West 6.65' R.E.I. "T" iron N89°-04'-37"W 18.62' closing cor. 1&2 T8N,R3E N89°-58'-35"E 2629.98' S 1/4 Sec. 36, T8N,R3E

B. Description of corner evidence found and/or method applied in restoring or reestablishing corner:

K-13 Found 1/2" bar by J. Quine per L 2 P 883-884 over stone and tiles by L. Mason, 1878 survey.


C. Description of monument for corner and accessories established to perpetuate locating the position of the corner:

K-13 Standard corner sections 35 & 36, T8N,R3E

Found record 1/2" bar w/10704 cap per L2, p884. Replaced bar w/Harrison marker, and is accepted as a careful and faithful perpetuation of the position of the original corner.

West 6.65' R.E.I. "T" iron West 18.62' 3/4" pipe, closing corner sec's 1&2, T7N,R3E S40°W 67.67' 12018 tag in N.W. side 40" oak (R) S75°W 60.90' N.E. cor. conc. HDWL. N75°W 57.60' S.E. " " " N45°E 40.10 12018 Tag in S.E. side 36" W. oak (R)

Grid table with columns A-M and rows 1-13. Numbers 6-36 are placed in the grid cells.

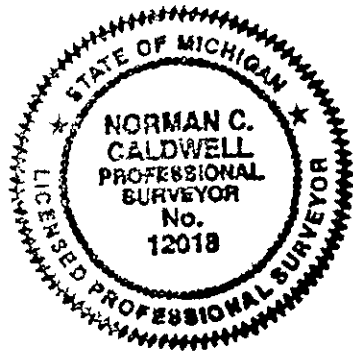

APPROVED 7/25/95 County Remonumentation Peer Review Group MLV.

Signed by Norman C. Caldwell Date 5 JULY 1995

Surveyor's Michigan License No. 12018

LIBER 1R PG 106