

269

Cor 1

001 3/1999

1999 REMONUMENTATION PROGRAM  
LAND CORNER RECORDATION CERTIFICATE  
Filing Requirement of Act 74, Mich. P.A. 1970

For corners in



3026104  
Page: 1 of 1  
10/05/1999 02:19P  
L-1 P-297

Shiawassee  
(County)

Located In: New Haven Twp

Corner Code #

Kaye Grubba - Shiawassee Co. REMON

- 1. Public Land Survey T8N R 3E L-7
- 2. Property Controlling S T R
- 3. Miscellaneous S T R
- 4. Lot No. \_\_\_\_\_ Recorded Plat \_\_\_\_\_
- 5. Private Claims \_\_\_\_\_

**APPROVED**  
County Remonumentation  
Peer Review Group  
1 OCT 99  
NCC

Register of Deeds Stamp & File Number

	A	B	C	D	E	F	G	H	I	J	K	L	M
1													
2	6	5	4	3	2	1							
3													
4	7	8	9	10	11	12							
5													
6	18	17	16	15	14	13							
7													
8	19	20	21	22	23	24							
9													
10	30	29	28	27	26	25							
11													
12	31	32	33	34	35	36							
13													

I, John H. Rauser, P.S., in a field survey on August 23 1999, do hereby certify that under requirements of P.A. 74, Michigan P.A. of 1970, the corner points mentioned in lines 1 and 2 above were in conformance with regulations and rules therefore as required in the current manual of survey instructions of the United States Department of the Interior, Bureau of Land Management or by a decree of a Court of Law and/or that the corner points mentioned in lines 3, 4 and 5 above were in conformance with the rules of the Michigan Board of Land Surveyors or by a Decree of a Court of Law; established, re-established, monumented, re-monumented, recovered, found as expressed below:

NOTE: Not more than 2 corners, all in the same town and range, may be recorded on this certificate.

A. Description of original monument and accessories and/or subsequent restoration:


**L-7** 1/4 Corner, Sections 13 & 24, T8N-R3E, New Haven Township, Shiawassee County  
 1822 Wood post placed by J. Wampler, D.S., Beech 12" N23W 28lks (18.48'); Beech 12" S22 1/2 E 98lks (64.68')  
 1870 County Survey by Ezra Mason, C.S. Book "A", P. 240, no object given, measured to M-7 39.68ch (2618.88), listed one witness N65 1/2 E 69lks (45.54) 4" Sugar  
 1969 Witnesses by J. F. Quine, P.S. 10704, County drain book 5, P. 80 found 1 1/2" iron rod flush, bent and with large stones around Stones extend to 12" deep. Witnesses: P/P WSW 103.2; Elm stump 18" SSW 23.5; Centerline of gravel rd North 6'  
 1975 Act 74 by J.F. Quine, P.S. 10704, L. 1, P.534, listed information from 1969 drain notes  
 1993 Act 132 by M.L. Vanraemdonck, P.S. 24622, L. 6, P. 619; found 1 1/4" iron rod, and witnessed by S60W 103.05' to N&T N fce P/P South 28.63' N&T W. fce 6" Elm; S70E 45.10' N&T N fce 6" Elm; N10E 27.05' S fce cable sign post, measured to M-7 2608.08'.  
 1998 Act 132 by J.H. Rauser, P.S. 39096, L. 8, P. 247; found 1" pipe in field notes and 1/4" bar in field sketch, South 14.89' Set PK w/ tag w fce tri 7" ash; S60E Set PK w/ tag in SW fce 6" Oak; N10E 25.02' 1/4 tele riser; N40W 25.80' set rod w/ cap 39096 in shoulder, measured to K-7 2611.88'.  
 Did not locate M-7 during the course of this survey.

B. Description of corner evidence found and/or method applied in restoring or reestablishing corner:

**L-7** 1/4 Corner, Sections 13 & 24, T8N-R3E, New Haven Township, Shiawassee County  
 Found no evidence of original government accessories or county survey accessories. Found 1 1/2" bar as per survey of record prior to 1998. 1998 record stated a pipe was found, but was probably an iron bar at that time also. Corner falls 6"± South of the approximate centerline of Henderson Road. Found no pipe or conflicting evidence in the area of this corner. Measured 2611.90 feet to K-7 and 2608.14 feet to the calculated position of M-7. Checked all record witnesses from 1969 drain record to present. We recommend accepting the found 1 1/2" iron bar as the best available evidence of the position of the original government corner and replacing it with a standard Shiawassee County Harrison monument 0.5' below grade in the gravel road.

C. Description of monument for corner and accessories established to perpetuate locating the position of the corner:

**L-7** 1/4 Corner, Sections 13 & 24, T8N-R3E, New Haven Township, Shiawassee County  
 Set a standard 20" Harrison monument at the position approved by the Shiawassee County Peer Review Group.  
 South 14.89' PK & tag #39096 W fce 7" triple Ash  
 S60°E 33.31' PK & tag #39096 SW fce 6" Oak  
 N10°E 25.02' Top center telephone riser  
 N40°W 25.80' Rod w/cap #39096 in road shoulder  
 WSW 103.2' Center of P/P  
 SSW 23.5'± Remains of stump

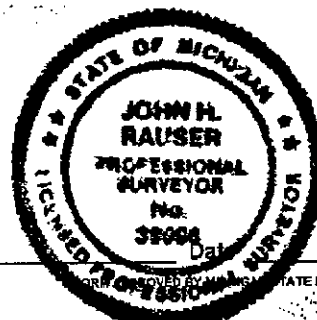

9/9/99

Signed by John H. Rauser  
Surveyor's Michigan License No. 39096