

1999 REMONUMENTATION PROGRAM
LAND CORNER RECORDATION CERTIFICATE
Filing Requirement of Act 74, Mich. P.A. 1970

For corners in



3026108
Page: 1 of 1
10/05/1999 02:19P
L-1 P-302

Shiawassee
(County)

Located In: Hazelton Twp

Corner Code # Kaye Grubba - Shiawassee Co. REMON

- 1. Public Land Survey T8N R4E L-7
- 2. Property Controlling in Section S T R
- 3. Miscellaneous Property in Sec. S T R
- 4. Lot No. , Recorded Plat
- 5. Private Claims

APPROVED
County Remonumentation
Peer Review Group
1 OCT 99
NCC

Register of Deeds Stamp & File Number

	A	B	C	D	E	F	G	H	I	J	K	L	M
1													
2	6	5	4	3	2	1							
3													
4	7	8	9	10	11	12							
5													
6	18	17	16	15	14	13							
7													
8	19	20	21	22	23	24							
9													
10	30	29	28	27	26	25							
11													
12	31	32	33	34	35	36							
13													

I, John H. Rauser, P.S., in a field survey on August 28 1999, do hereby certify that under requirements of P.A. 74, Michigan P.A. of 1970, the corner points mentioned in lines 1 and 2 above were in conformance with regulations and rules therefore as required in the current manual of survey instructions of the United States Department of the Interior, Bureau of Land Management or by a decree of a Court of Law and/or that the corner points mentioned in lines 3, 4 and 5 above were in conformance with the rules of the Michigan Board of Land Surveyors or by a Decree of a Court of Law; established, re-established, monumented, re-monumented, recovered, found as expressed below:

NOTE: Not more than 2 corners, all in the same town and range, may be recorded on this certificate.

A. Description of original monument and accessories and/or subsequent restoration:


L-7 1/4 Corner, Secs. 13 & 24, T8N-R4E, Hazelton Township, Shiawassee County
 1822 Wood post placed by J. Wampler, D.S., Elm 12" N50E 20 lks (13.2'); Ash 6" S21W 20 lks (13.2'), measured to M-7 39.97 ch and to K-7 39.97 ch. (2637.36').
 1971 Act 74 by E.J. McCombs, L1, P.16, found 1 1/2" pipe in line fence to North and in CL Blacktop Rd., witnesses 12" Ash S35E 38.2', 12" Ash S45E 43.95'; Power Pole N65E 92.1'
 1972 Consumers Power Company Survey by E.J. McCombs, Found 1/2" iron brought to surface with spike, survey of Sec. 13, T8N-R4E 12" Ash S35E 38.2', 12" Ash S45E 43.95'; Power Pole N65E 92.1' and in line with fence to North and centerline of blacktop. Measured West to K-7 2635.92', did not measure to East.
 1995 Act 132 by J.H. Rauser, P.S. 39096, L. 7, P287-289, found 1 1/2" pipe in monument box, witnessed by: S35E 38.43' Set nail & tag W. fce 14" Ash; S45E 77.02' Set nail & tag W fce 12" Ash; North 45.48' Set nail & tag W fce 20" Ash; N65 E 92.25' Set nail & tag S. fce P/P, measured K-7 to L-7, 2635.91' in field traverse and to M-7 = 2625.61'.

B. Description of corner evidence found and/or method applied in restoring or reestablishing corner:

L-7 1/4 Corner, Secs. 13 & 24, T8N-R4E, Hazelton Township, Shiawassee County
 Found no evidence of original government accessories. Found 1 1/2" pipe in monument box at the centerline of Henderson Road and in line with occupation North and South. Found no conflicting evidence near this position of L-7. Verified witnesses from 1971 McCombs survey to present (S35E 38.36' spike w/tag 39096 in SW fce 18" Ash; S45E 43.97' spike w/tag 39096 SW fce 15" Ash; N65E 92.39' PK w/tag 39096 SE fce P/P; North 45.60 spike in W fce 24" Ash). Measured West to K-7 = 2635.87' and East to M-7 = 2625.61'. We recommend that the found 1 1/2" pipe in monument box be accepted as the best available evidence of the position of the original government corner and be replaced with a standard Shiawassee County Harrison monument in the existing monument box. During excavation for the monument found hole in circle of stones below monument box in same position as 1 1/2" pipe.

C. Description of monument for corner and accessories established to perpetuate locating the position of the corner:

L-7 1/4 Corner, Secs. 13 & 24, T8N-R4E, Hazelton Township, Shiawassee County
 Set a standard 20" Harrison monument in an existing monument box at the position approved by the Shiawassee Count Peer review Group.
 S35°E 38.36' Fnd spike/tag #39096 in SW fc 18" Ash
 S47°E 43.97' Fnd spike/tag #39096 in SW fc 15" Ash
 N74°E 92.39' Fnd PK/tag #39096 in SE fc PP
 N02°W 45.60' Fnd spike/tag #39096 in W fc 24" Ash
 N01°W 28.57' Fnd rod/cap #24622
 North 2.33' Set PK nail in asphalt surface
 S80°W 1.74' Set BK nail in asphalt surface

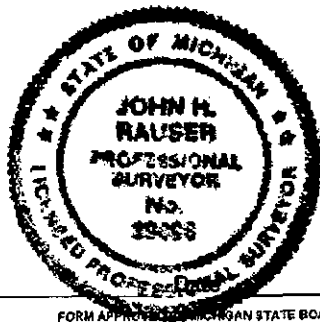

9/9/99

Signed by John H. Rauser
Surveyor's Michigan License No. 39096