

OST 7 1999

SECTION

1999 REMONUMENTATION PROGRAM
LAND CORNER RECORDATION CERTIFICATE
Filing Requirement of Act 74, Mich. P.A. 1970

For corners in

Shiawassee
(County)

Located In:
Hazelton Twp

Corner Code #



3025110
Page: 1 of 1
10/05/1999 02:19P
L-1 P-303

- 1. Public Land Survey T8N R4E M-7
- 2. Property Controlling S T R
- 3. Miscellaneous S T R
- 4. Lot No. Recorded Plat
- 5. Private Claims

APPROVED
County Remonumentation
Peer Review Group
1 OCT 99
NKL

Register of Deeds Stamp & File Number


	A	B	C	D	E	F	G	H	I	J	K	L	M
1													
2	6	5	4	3	2	1							
3													
4	7	8	9	10	11	12							
5													
6	18	17	16	15	14	13							
7													
8	19	20	21	22	23	24							
9													
10	30	29	28	27	26	25							
11													
12	31	32	33	34	35	36							
13													

I, John H. Rauser, P.S., in a field survey on September 17, 1999, do hereby certify that under requirements of P.A. 74, Michigan P.A. of 1970, the corner points mentioned in lines 1 and 2 above were in conformance with regulations and rules therefore as required in the current manual of survey instructions of the United States Department of the Interior, Bureau of Land Management or by a decree of a Court of Law and/or that the corner points mentioned in lines 3, 4 and 5 above were in conformance with the rules of the Michigan Board of Land Surveyors or by a Decree of a Court of Law; established, re-established, monumented, re-monumented, recovered, found as expressed below:

NOTE: Not more than 2 corners, all in the same town and range, may be recorded on this certificate.

- A. Description of original monument and accessories and/or subsequent restoration:**
M-7. Standard Section Corner, Secs. 13 & 24, T8N-R4E, Hazelton Township, Shiawassee County
 1822 Wood post placed by J. Wampler, D.S., Beech 8" N21W 23 lks (15.18'); Ironwood 13" S41W 6 lks (3.96')
 1822 GLO notes by Horatio Ball, D.S. made closing call of 4.67ch (308.22') to M-7 in notes from A-7, T8N-R5E
 1972 Consumers Power Company by E.J. McCombs
 1987 Act 132 by J.N. Owens, P.S. 20709, L.5, P. 106, set PK w/tag 11192 at a position established by retracement of the standard line of T8N-R4E, from M-9 to M-3, using State Highway construction plans and GLO notes. Witnesses S50W 72.51' NW edge stop sign; N70W 66.02' E edge road sign post; S45E 43.23' N edge N leg traffic sign; S15W 128.18' E edge M-13 sign; North 308.22' NW Cor Section 19, T8N-R5E
 1987 Act 74 by J.N. Owens, L. 2, P. 494, states the same information as in recorded Act 132 from 1987
 1991 Act 132 by P.N. Brown, P.S. 33134, L. 2444, P. 940, GCR, found PK w/tag shows M-7 on page 2 of survey, no witnesses given
 1995 Act 132 by J.H. Rauser, P.S. 39096, L. 7, P287-289, found PK w/tag, witnessed by N70W 66.19' E edge rd sign post; S50W 72.55' N edge E leg sign post; S15W 128.16' E edge M-13 sign post; North 308.22' SW cor, Sec. 18, T8N-R5E and West to L-7 = 2625.61' and North to M-6 = 2598.97'
- B. Description of corner evidence found and/or method applied in restoring or reestablishing corner:**
M-7. Standard Section Corner, Secs. 13 & 24, T8N-R4E, Hazelton Township, Shiawassee County
 Found no evidence of original government accessories. New milling and asphalt overlay on M-13 has removed the record PK and tag. Found PK nail 17.05' West of M-7 (calc position 308.22 South of found A-7 on line with A-9) and 0.09' South of line between M-7 and L-7. Found 3/8" rod in monument box at A-7, T8N-R5E, corner is recorded as a chisled "V" on the inner recessed lip of the monument box, as per 1987 Act 74 by J.N. Owens and 1991 Act 72 by P.N. Brown. Measured West to L-7 = 2625.61', North to M-6 2599.02' and South to M-9 5285.98' (prev. measure M-7 to M-9 1987 record = 5286.35'). Found no conflicting evidence near this position of M-7. We recommend accepting the calculated position of the record 1987 position as the best available evidence of the position of the original government corner and place a 1/2" re-rod under a 5/8" re-rod welded to a standard Shiawassee County Harrison top and place a custom monument box which is bolted into the concrete pavement below the asphalt overlay.
- C. Description of monument for corner and accessories established to perpetuate locating the position of the corner:**
M-7. Standard Section Corner, Secs. 13 & 24, T8N-R4E, Hazelton Township, Shiawassee County
 Set a 1/2" re-rod under a 5/8" re-rod welded to a standard Shiawassee County Harrison top and place a custom monument box which is bolted into the concrete pavement below the asphalt overlay at the position approved by the Shiawassee County Peer review Group.

- West 17.48' Found PK nail (R=17.05')
- North 308.20' A-7, T8N-R5E (R=308.22')
- S46W 43.80' N. edge N. leg <-> sign
- S52W 72.13' N. edge N. leg stop sign
- N36E 151.60' Set PK & tag 39096 S. face P/P
- N71W 66.00' E. edge road sign post (R=66.19')
- S09W 142.31' E. edge M-13 sign post

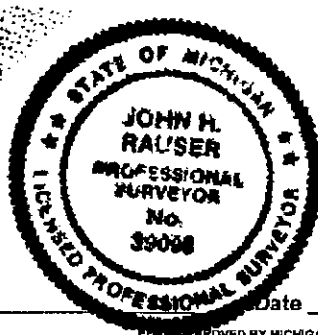

Signed by John H. Rauser
Surveyor's Michigan License No. 39096

Date 9/23/99