

SURVEY & REMONUMENTATION

MAY 05 1997

1996 REMONUMENTATION PROGRAM LAND CORNER RECORDATION CERTIFICATE

Filing Requirement of Act 74, Mich. P.A. 1970

COMMISSION

For corners in ARBELA TWP.

TUSCOLA

(County)

Located In: _____

Corner Code # _____

- | | | |
|------------------------------------|---------------------------|-------|
| 1. Public Land Survey | T <u>10N</u> R <u>07E</u> | A-1 ✓ |
| | T _____ R _____ | A-13 |
| | T <u>11N</u> R <u>07E</u> | _____ |
| | T _____ R _____ | _____ |
| 2. Property Controlling in Section | S _____ T _____ R _____ | _____ |
| | S _____ T _____ R _____ | _____ |
| 3. Miscellaneous Property in Sec. | S _____ T _____ R _____ | _____ |
| | S _____ T _____ R _____ | _____ |

4. Lot No. _____ Recorded Plat _____
5. Private Claims _____

I, JONATHAN M. FIELD, in a field survey on AUGUST 5 1994, do hereby certify that under requirements of P.A. 74, Michigan P.A. of 1970, the corner points mentioned in lines 1 and 2 above were in conformance with regulations and rules therefore as required in the current manual of survey instructions of the United States Department of the Interior, Bureau of Land Management or by a decree of a Court of Law and/or that the corner points mentioned in lines 3, 4 and 5 above were in conformance with the rules of the Michigan Board of Land Surveyors or by a Decree of a Court of Law; established, re-established, monumented, re-monumented, recovered, found as expressed below:

NOTE: Not more than 4 corners, all in the same town and range, may be recorded on this certificate.

- A. Description of original monument and accessories and/or subsequent restoration:
- 1821 GLO; WAMPLER, D.S.; SET POST; BIRCH 30 N35E 2LKS., MAPLE 7 S13E 29LKS.
 - 1968 CPCCO; BOLDT; FND 1" ROD; NW 38.44' RD SIGN, SE 59.39' POLE, SW 74.84' POLE
 - 1978 PREVOST, P.S.#24612; LCRC 38; FND T-IRON; N45W 38.64' FACE T.POLE, N44W 38.10' CENTER RD SIGN POST, S45W 74.52' FACE P.POLE, S40E 58.97' FACE P.POLE, S45E 43.03' CENTER RD SIGN POST
 - 1980 SPICER ENG.; MARTIN, P.S.#4699; SURVEY L.505, PG.132-133; T-IRON; SAME WITS AS 1978 LCRC
 - 1981 DUNTON SURVEYING; DUNTON, P.S.#23503; SURVEY L.515, PG.940-941; NO OBJECT STATED; DIST. OF 852.04' TO B-13
 - 1993 SPICER ENG.; PREVOST, P.S.#24612; SURVEY L.671, PG.1182; T-IRON; SAME WITS AS 1978 LCRC

- B. Description of corner evidence found and/or method applied in restoring or reestablishing corner:
- 1994 ROWE ENG.; FIELD, P.S.#37276; FND. T-IRON AT C/L-C/L OF ROADS N-S-E-W FND. 3 PREVIOUS WITNESSES INDICATING T-IRON IS IN SAME POSITION AS 1968 1" ROD

ACCEPTED T-IRON AS BEST EVIDENCE OF ORIGINAL CORNER POSITION

- C. Description of monument for corner and accessories established to perpetuate locating the position of the corner:
- A-1 REMOVED T-IRON, SET STANDARD REMON MONUMENT STAMPED "A 13 T11N R7E" IN MON. BOX
- N49°E, 30.15' SET 1/2" ROD
 - S29°E, 35.12' CENTER OF ROAD SIGN POST
 - S32°E, 59.43' FND. NAIL W/DISK IN SW FACE P.POLE
 - S47°W, 74.05' FND. NAIL W/DISK IN NW FACE P.POLE
 - S47°W, 74.86' CENTER OF CUT-OFF P.POLE
 - N50°W, 38.78' FND. NAIL W/DISK IN ENE FACE CUT-OFF P.POLE
 - N43°W, 38.41' CENTER OF ROAD SIGN POST

This corner is common with A-13 T11N-R7E ✓
NOTE: MONUMENT AND ACCESSORIES SET 11-24-94

Signed by Jonathan M Field Date 12-23-96
Surveyor's Michigan License No. 37276


APPROVED
12-11-96
[Signature]

RECEIVED FOR RECORD
LIBER NO. _____ PAGE NO. 05
FILE NO. Arbela Twp.
96 DEC 26 AM 11:50

TUSCOLA COUNTY
REGISTER OF DEEDS

Register of Deeds Stamp & File Number

1	A	B	C	D	E	F	G	H	I	J	K	L	M
2		6	5	4	3	2	1						
3													
4		7	8	9	10	11	12						
5													
6		18	17	16	15	14	13						
7													
8		19	20	21	22	23	24						
9													
10		30	29	28	27	26	25						
11													
12		31	32	33	34	35	36						
13													

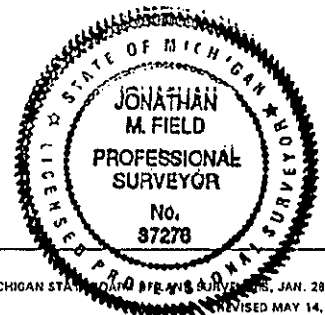

FORM APPROVED BY MICHIGAN STATE BOARD OF SURVEYORS, JAN. 28, 1971
REVISED MAY 14, 1975
REVISED JAN., 1983
ADAPTED FOR WORD PROCESSING MARCH, 1993

