

**SURVEY &  
REMONUMENTATION**

DEC 02 1993

**COMMISSION**

**1993 REMONUMENTATION PROGRAM  
LAND CORNER RECORDATION CERTIFICATE  
Filing Requirement of Act 74, Mich. P.A. 1970**

For corners in <u>TUSCOLA</u> <small>(County)</small>	Located In:	<b>ARBELA TOWNSHIP</b>	Corner Code #
1. Public Land Survey	T <u>10</u> N R <u>7</u> E		<u>E-13</u>
	T _____ R _____		_____
	T _____ R _____		_____
	T _____ R _____		_____
2. Property Controlling in Section	S _____ T _____ R _____		_____
	S _____ T _____ R _____		_____
3. Miscellaneous Property in Sec.	S _____ T _____ R _____		_____
	S _____ T _____ R _____		_____

RECEIVED FOR RECORD  
LIBER NO. \_\_\_\_\_ PAGE NO. 84  
FILING NO. ArbelaTwp.  
93 NOV -8 PM 4: 03  
VIRGINIA M. McLAUREN  
TUSCOLA COUNTY  
REGISTER OF DEEDS

Register of Deeds Stamp & File Number

4. Lot No. \_\_\_\_\_ Recorded Plat \_\_\_\_\_  
5. Private Claims \_\_\_\_\_

I, JONATHAN M. FIELD, in a field survey on OCTOBER 19 93, do hereby certify that under requirements of P.A. 74, Michigan P.A. of 1970, the corner points mentioned in lines 1 and 2 above were in conformance with regulations and rules therefore as required in the current manual of survey instructions of the United States Department of the Interior, Bureau of Land Management or by a decree of a Court of Law and/or that the corner points mentioned in lines 3, 4 and 5 above were in conformance with the rules of the Michigan Board of Land Surveyors or by a Decree of a Court of Law; established, re-established, monumented, re-monumented, recovered, found as expressed below:

**NOTE: Not more than 4 corners, all in the same town and range, may be recorded on this certificate.**


1	A	B	C	D	E	F	G	H	I	J	K	L	M
2		6		5		4		3		2		1	
3													
4		7		8		9		10		11		12	
5													
6		18		17		16		15		14		13	
7													
8		19		20		21		22		23		24	
9													
10		30		29		28		27		26		25	
11													
12		31		32		33		34		35		36	
13													

- A. Description of original monument and accessories and/or subsequent restoration:**  
 1821 GLO - WAMPLER, D.S. - SET POST; BEECH 12" S73E 7 LKS, BEECH 12" S69W 8 1/2 LKS  
 1968 CPCO - ANKROM, P.S. #21265; SURVEY OF SEC.32,T10N-R9E - NO OBJECT SHOWN, NO WITS GIVEN  
 1973 ROWE ENG. - ROWE, P.S. #11192; UNRECORDED SURVEY JOB NO. C-0948-73-S - P-K NAIL; S65E 40.90' TAG #11192  
 14" HICKORY, WEST 66.05' SEC COR GENESEE CO, N45E 74.58' TAG #11192 P.POLE  
 1973 LEACH, P.S. #7236; SURVEY L.435, PG.186-187 - FND 1/2" SPIKE; N30E 43.40' 4" GAS LINE MARKER, S60E 27.51' 18" ASH, SOUTH 19.30' TOWN INFO SIGN  
 1973 LEACH, P.S. #7236; LCRC PG.33 - FND 1/2" SPIKE; WITS SAME AS LEACH SURVEY CITED ABOVE  
 1973 ROWE, P.S. #11192; LCRC PG.34 - RE-SET P-K NAIL FROM OLD TIES; WITS SAME AS REI SURVEY CITED ABOVE  
 1973 ROWE ENG. - DUNTON, P.S. #23503; WIT CARD - FND P-K NAIL, SET RE-ROD; WITS SAME AS REI SURVEY ABOVE  
 1973 ROWE ENG. - ROWE, P.S. #11192; SURVEY L.436, PG.273-274 - P-K NAIL; SAME WITS AS 1973 ROWE WIT CARD  
 1975 LEACH, P.S. #7236; SURVEY L.450, PG.588 - FND 1/2" SPIKE, NO WITS GIVEN, HOWEVER 1/4 MILE DIST SHOWN INDICATES SAME CORNER POSITION AS LEACH 1973 SURVEY ABOVE  
 1975 ROWE, P.S. #11192; LCRC PG.50 - FND P-K NAIL, SET RE-ROD (FIELD SURVEY DATE NOV. 1973) WITS SAME AS 1973 ROWE WIT CARD ABOVE
- B. Description of corner evidence found and/or method applied in restoring or reestablishing corner:**  
 1993 ROWE ENG. - FIELD, P.S.#37276; FND 1/2" ROD IN MON BOX AT EXTENDED C/L OF ASPH RD N. AND 3' S. OF ASPH RD E-W; 2 PREV WITS VERIFY SAME POSITION AS ROWE 1973 WIT CARD CITED IN "A" ABOVE  
 ACCEPTED 1/2" ROD AS BEST EVIDENCE OF ORIGINAL CORNER POSITION

**COPY**

SEE ALSO BACK OF THIS FORM


- C. Description of monument for corner and accessories established to perpetuate locating the position of the corner:**  
 E-13 SET STANDARD MONUMENT (5/8" ROD W/ BRASS CAP IN CONC, IN MON BOX)  
 N16°E, 69.80' SET PUNCH HOLE IN TOP CENTER E. END 18" CSP  
 N51°E, 74.58' SET NAIL W/REMON TAG ABOVE NAIL W/DISK SE FACE P.POLE  
 S01°E, 30.26' W. EDGE OF W. LEG OF DIRECTIONAL SIGN  
 N51°W, 93.89' SET NAIL W/REMON TAG NE FACE P.POLE  
 WEST, 66.07' 5/8" ROD IN MON BOX

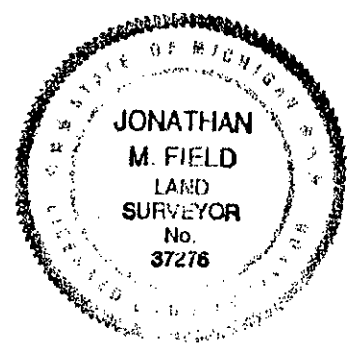

Signed by Jonathan M. Field Date 10-27-93  
 Surveyor's Michigan License No. 37276

**APPROVED**  
10-18-93  
*[Signature]*

COPY

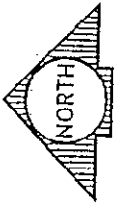

SECTION 32

T10N-R7E

D-13

1821 GLO 2640'  
1968 CPCO 2629.08'  
1993 REI 2622.22'

SECTION 33

T10N-R7E

F-13

1821 GLO 2640'  
1993 REI 2646.86'

F-13

1821 GLO 72.60'  
1973 REI 66.05'  
1993 REI 66.07'

E-1  
(APPARENT)

FND 5/8" ROD IN  
MON BOX  
2.39' N

SECTION 5

T9N-R7E

SECTION 4

T9N-R7E