

**SURVEY &
REMONUMENTATION**

DEC 02 1993

COMMISSION

**1993 REMONUMENTATION PROGRAM
LAND CORNER RECORDATION CERTIFICATE
Filing Requirement of Act 74, Mich. P.A. 1970**

For corners in TUSCOLA (County) Located In: ARBELA TOWNSHIP Corner Code # _____

1. Public Land Survey T 10 NR 7 E I-13
 T _____ R _____
 T _____ R _____
 T _____ R _____

2. Property Controlling in Section S _____ T _____ R _____
 S _____ T _____ R _____

3. Miscellaneous Property in Sec. S _____ T _____ R _____
 S _____ T _____ R _____

4. Lot No. _____ Recorded Plat _____

5. Private Claims _____

RECEIVED FOR RECORD
 LIBERNO. PAGE NO. 88
 FILING NO. Arbela Twp.
 93 NOV -8 PM 4: 03
 VIRGINIA M. HALLAMER
 TUSCOLA COUNTY
 REGISTER OF DEEDS
 Register of Deeds Stamp & File Number


1	A	B	C	D	E	F	G	H	I	J	K	L	M
2	6	5	4	3	2	1							
3													
4	7	8	9	10	11	12							
5													
6	18	17	16	15	14	13							
7													
8	19	20	21	22	23	24							
9													
10	30	29	28	27	26	25							
11													
12	31	32	33	34	35	36							
13													

I, JONATHAN M. FIELD, in a field survey on OCTOBER 19 93, do hereby certify that under requirements of P.A. 74, Michigan P.A. of 1970, the corner points mentioned in lines 1 and 2 above were in conformance with regulations and rules therefore as required in the current manual of survey instructions of the United States Department of the Interior, Bureau of Land Management or by a decree of a Court of Law and/or that the corner points mentioned in lines 3, 4 and 5 above were in conformance with the rules of the Michigan Board of Land Surveyors or by a Decree of a Court of Law; established, re-established, monumented, re-monumented, recovered, found as expressed below:

NOTE: Not more than 4 corners, all in the same town and range, may be recorded on this certificate.

- A. Description of original monument and accessories and/or subsequent restoration:
 1821 GLO - WAMPLER, D.S.; SET POST; BEECH 20" EAST 24 LKS, BEECH 22" S6W 10 LKS
 1891 FELTON, C.S.; FND CORNER SET BY MIDDLETON IN 1890, NO OBJECT STATED; W.OAK 6" S5BW 55 LKS, PINE 36" N48 1/2W 99 1/2 LKS
 1972 CPCC - DORCEY, P.S. #9429; SURVEY OF SEC. 3, T9N-R7E; NO OBJECT STATED, JOG DIST OF 43.7' SHOWN I-1, T9N-R7E TO I-13 T10N-R7E, NO OTHER WITS GIVEN

- B. Description of corner evidence found and/or method applied in restoring or reestablishing corner:
 1993 ROWE ENG. - FIELD, P.S. #37276; FND 1/2" ROD W/CAP #2459? (8 OR 3) AT OCCUPIED FENCE & BRUSH LINE NORTH AND ON C/L GRAV RD E-W; FND NO OTHER EVIDENCE
 ACCEPTED 1/2" ROD AS BEST EVIDENCE OF ORIGINAL CORNER POSITION

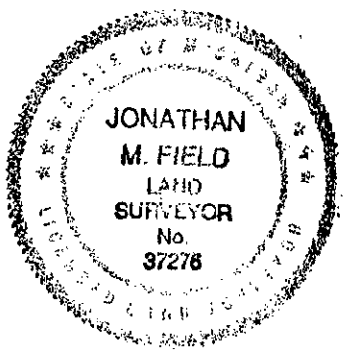

SEE ALSO BACK OF THIS FORM


- C. Description of monument for corner and accessories established to perpetuate locating the position of the corner:
 I-13 REMOVED 1/2" ROD, SET STANDARD MONUMENT (5/8" ROD W/BRASS CAP IN CONC)
 N02°E, 32.91' SE COR OF CONC PILLAR FENCE POST
 N71°E, 69.74' SET NAIL W/REMON TAG NW FACE TWIN 12" ELM
 S15°E, 41.59' SET NAIL W/REMON TAG ABOVE BENT DBL HEAD NAIL NE FACE P. POLE (ALSO P-K NAIL W/FLAG. IN NW FACE)
 S66°W, 86.56' FND 1/2" ROD W/KRAFT ENG. CAP IN CONC
 S67°W, 65.86' SET NAIL W/REMON TAG ABOVE DBL. HEAD NAIL NW FACE P. POLE
 N64°W, 83.17' SET NAIL W/REMON TAG NE FACE CUT-OFF T. POLE (ALSO P-K W/FLAG. E. FACE) POLE LEANS S'LY
 WEST, 42.90' FND 1/2" ROD IN MON BOX

Signed by Jonathan M. Field Date 10-29-93
 Surveyor's Michigan License No. 37276

COPY

APPROVED
10-19-93
 J. P. E.
 1400
 10/19/93

COPY

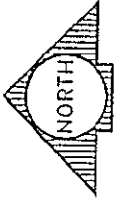

SECTION 35

T10N-R7E

J-13

1821 GLO 2640'
1993 REI 2582.60'

I-13

1821 GLO 49.50'
1972 CPCO 43.7'
1993 REI 42.90'

END 1/2" ROD
IN MON BOX
4.87' N

I-1
(APPARENT)

1891 FELTON 2691.48'
1993 REI 2702.89'

H-13

SECTION 34

T10N-R7E

SECTION 2

T9N-R7E

SECTION 3

T9N-R7E