SURVEY & REMONUMENTATION

FEB 08 2001



SECTION

For corners in: ARBELA TWP.

2000 REMONUMENTATION PROGRAM LAND CORNER RECORDATION CERTIFICATE RECEIVED FOR RECORD FILE NO. #121 Arbela

Filing Requirement of Act 74, Mich. P.A. 1970

Tuscola Located In	: Corner Code #	00 DEC 19 PH 1:37
1. Public Land Survey	T_10N R_7E K-2 T R T R T R	TUSCOLA COMETY REGISTER OF PUEDS
2. Property Controllingin Section3. Miscellaneous	S	Register of Deeds Stamp & File Number
Property in Sec.	S R	
hereby state that under requir points mentioned in lines 1 ar rules therefore as required i United States Department of th of a Court of Law and /or tha above were in conformance with by a Decree of a Court of Law; found as expressed below:	a field survey on August 29, 20 rements of P.A. 74, Michigan P.A. of 1970 of 2 above were in conformance with reg on the current manual of survey instruct in Enterior, Bureau of Land Management of it the corner points mentioned in line the rules of the Michigan Board of Land established, re-established, monumente	I, the Corner ulations and trions of the by a decree 5 3, 4 and 5 Surveyors or 1, recovered,
1822 G.L.O. NOTES, JOSEPH JULY 26, 1991, SURVEY L.64 S 25 E 49.45' 20" MAPLE, S 86 B. Description of corner FOUND 1" PIPE SEVERELY E PIPE FROM 3 ACCESSORIES ACCEPTED RE-ESTABLISHE C. Description of monume the corner: REMOVED 1" PIPE AND SET R7E. EAST, 18.36' SET REMON. TA S 50° E, 22.14' SET REMON. TO S 18° E, 49.46' SET REMON.	6, P.389-390, A.F. MILLER, PS 12024, FD E 22.10' 18" MAPLE, EAST 18.54' 20' or evidence found and/or method appointment of EENT, ON EXTENSION OF OCCUPIED RECOVERED FROM 1991 SURVEY CONTROL OF 1" PIPE AS BEST EVIOUS OF CONCRETE MONUMENT WITH SAG & NAIL IN N. FACE OF 20" MAPLE FAG & NAIL ABOVE FOUND NAIL IN FAG & NAIL ABOVE FOUND NAIL IN FAG & NAIL ABOVE FOUND NAIL IN	ECH 18 N.29 E 23, BEECH 9 N 12 W 12 FOUND % "PIPE, S 25 W 37.40' 6" TREE, MAPLE Lied in restoring or reestablishing corner: LINE TO EAST. RE-ESTABLISHED POSITION OF ITED ABOVE. DENCE OF ORIGINAL CORNER POSITION. blished to perpetuate locating the position of STANDARD BRASS CAP STAMPED K-2, T10N-
S 45° W, 22.58' SET ½" REBA Signed by		MARIM. SEE


FORM APPROVED BY MICHIGAN WHATE BOARD OF PROFESSIONAL SURVEYORS, JAN. 28, 197: APPROVED BY TUSCOLA COUNTY ISSUE REMONUMENTATION PEER GROUP MWP REVISED MAY 14,197! REVISED JAN., 1985 REVISED OCT., 1995 1210612000

Surveyor's Michigan License No. 442899

of

FEB 08 2001


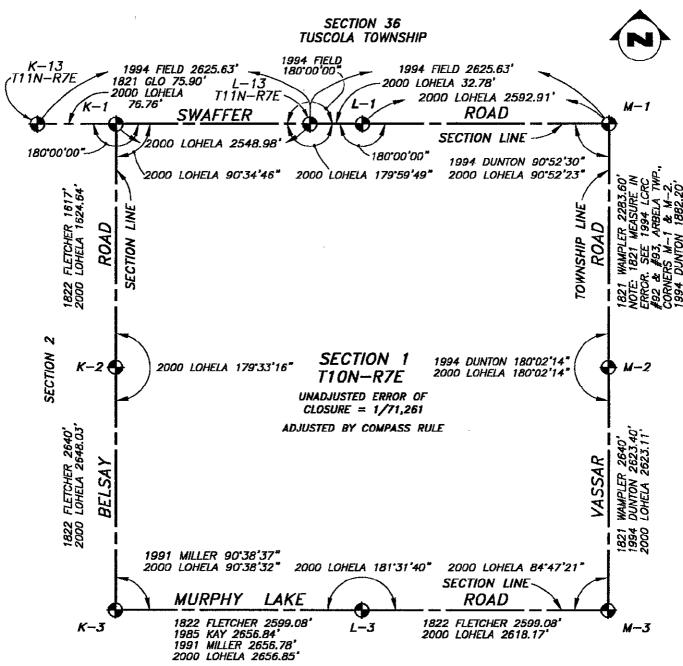

SECTION 12