

1999
 REMONUMENTATION PROGRAM
LAND CORNER RECORDATION CERTIFICATE
 Filing Requirement of Act 74, Mich. P.A. 1970

For corners in Arbela Twp.

<u>Tuscola</u> (County)	Located in:	Corner Code #
1. Public Land Survey	<u>T10N R7E</u>	<u>K-10</u>
	T <u> </u> R <u> </u>	<u> </u>
	T <u> </u> R <u> </u>	<u> </u>
	T <u> </u> R <u> </u>	<u> </u>
2. Property Controlling in Section	S <u> </u> T <u> </u> R <u> </u>	<u> </u>
	S <u> </u> T <u> </u> R <u> </u>	<u> </u>
3. Miscellaneous Property in Sec.	S <u> </u> T <u> </u> R <u> </u>	<u> </u>
	S <u> </u> T <u> </u> R <u> </u>	<u> </u>

RECEIVED FOR RECORD
 LIBER NO. _____ PAGE NO. _____
 FILE NO. A109
ARBELA TWP.
09 DEC -7 PM 3:57

TUSCOLA COUNTY
 REGISTER OF DEEDS

Register of Deeds Stamp & File Number

4. Lot No. _____, Recorded Plat _____
 5. Private Claims _____

I, Kenneth D. Dunton, in a field survey on July 18, 1999 do hereby state that under requirements of P.A. 74, Michigan P.A. of 1970, the corner points mentioned in lines 1 and 2 above were in conformance with regulations and rules therefore as required in the current manual of survey instructions of the United States Department of the Interior, Bureau of Land Management or by a decree of a Court of Law and for that the corner points mentioned in lines 3, 4 and 5 above were in conformance with the rules of the Michigan Board of Land Surveyors or by a Decree of a Court of Law, established, re-established, monumented, recovered, found as expressed below:

NOTE: Not more than 2 corners, all in the same town and range, may be recorded on this certificate.

	A	B	C	D	E	F	G	H	I	J	K	L	M
1													
2		6		5		4		3		2		1	
3													
4		7		8		9		10		11		12	
5													
6		18		17		16		15		14		13	
7													
8		19		20		21		22		23		24	
9													
10		30		29		28		27		26	●	25	
11													
12		31		32		33		34		35		36	
13													

A. Description of original monument and accessories and/or subsequent restoration:

June 1822, Joseph Fletcher, DS., set 1/4 corner to Secs. 25 & 26, T10N-R7E, Sugar 10" S77°W 15 links, Sugar 9" N59°E 12 links. April 11, 1973 L.C.R.C. Page 26 by David T. Rowe, P.S. #11192, found nail in asphalt, N30°W 69.27' nail in P.P., N55°E 37.50' nail in T.P., S55°E 42.64' Co. Rd. sign post. Feb. 8, 1974 Survey L-438, P-63 by David T Rowe, P.S. #11192, found concrete nail, N30°W 69.26' conc. nail & tag in P.P., N30°E 37.49' conc. nail & tag in P.P., S70°E 42.65' NW face road sign. Dec. 10, 1976 L.C.R.C. Page 54 by David T. Rowe, P.S. #11192, found 3/4" pipe below asph. surface 8.82' SE of previous found & witnessed nail, N30°W 60.75' nail & tag in P. Pole, N60°E 35.90' nail & tag in T. pole, S45°E 49.90' face of Co. Rd. sign, SE 8.82' conc. nail at centerline-centerline. Sec. A Con't on back of form.

B. Description of corner evidence found and/or method applied in restoring or reestablishing corner:

1999 K-10 Found 3/4" pipe in monument box. Accepted the 3/4" pipe as the best evidence of the original corner position.

C. Description of monument for corner and accessories established to perpetuate locating the position of the corner:


K-10 Drove 3/4" pipe down and placed 5/8" iron rod & brass cap above. Standard brass cap stamped K-10, T10N-R7E. Encased pipe, rod & cap in concrete in mon. box.
 S30°W 30.57' fnd. 1/2" iron rod & cap #37276.
 N35°W 61.23' fnd. nail & tag #37276 in SW face P. Pole (fnd. 11192 tag in SE face).
 N67°E 35.97' fnd. nail & tag #32332 in S. face Tele. stub (fnd. 11192 tag in SE face).
 S59°E 40.91' fnd. nail & tag #32332 in NE face 6" wood corner post.
 East 2.8'± N-S physical centerline asphalt pavement.

Signed by *Kenneth D. Dunton*
 Surveyor's Michigan License No. 23503

Date 12-1-1999

APPROVED
12-1-1999

KDD
KML
RBB

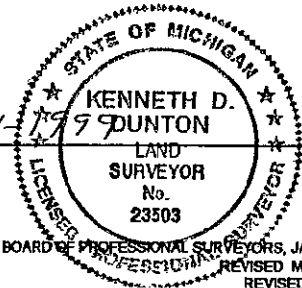

Sec. A Con't.

Dec. 10, 1976 Survey L-468, Page 285 by Jan S. Fokens, P.S. #21567, found 3/4" pipe below asphalt surface, accessories same as L.C.R.C. Page 54. Oct. 14, 1988 Survey L-588, P-1278 & 1279 by Kenneth D. Dunton, P.S. #23503, no mention of object found or set or accessories. July 1, 1996 Survey L-707, P-1147 by John M. Juras, P.S. #33980, nail, accessories same as L.C.R.C. Page 26. July 30, 1996 Survey L-695, P-474 by Jonathan M. Field, P.S. #37276, fnd. 3/4" pipe in mon. box, S57°E 40.80' nail & tag #32332 in N. face fence post, N69°E 35.89' nail & tag #11192 in SW face P. Pole, N28°W 60.69' nail & tag #11192 in SW face P. Pole, S35°W 30.48' 1/2" rod w/cap #37276.

