

**SURVEY & REMONUMENTATION**

APR 25 1995

**COMMISSION**

1994 REMONUMENTATION PROGRAM  
**LAND CORNER RECORDATION CERTIFICATE**  
 Filing Requirement of Act 74, Mich. P.A. 1970

**COPY**

For corners in Arbela Township  
Tuscola  
 (County)

Located In:	Corner Code #/
T <u>10N</u> R <u>7E</u>	<u>M-3</u>
T _____ R _____	_____
T _____ R _____	_____
T _____ R _____	_____
S _____ T _____ R _____	_____
S _____ T _____ R _____	_____
S _____ T _____ R _____	_____
S _____ T _____ R _____	_____

RECEIVED FOR RECORD  
 LIBER NO. \_\_\_\_\_ PAGE NO. \_\_\_\_\_  
 FILING NO. #94  
ARBELA TWP  
 94 DEC -1 PM 4: 26  
 VIRGINIA M. HCLAREN  
 TUSCOLA COUNTY  
 REGISTER OF DEEDS  
**Register of Deeds Stamp & File Number**

4. Lot No. \_\_\_\_\_, Recorded Plat \_\_\_\_\_  
 5. Private Claims \_\_\_\_\_

I, Kenneth D. Dunton, in a field survey on August 7, 1994, do hereby certify that under requirements of P.A. 74, Michigan P.A. of 1970, the corner points mentioned in lines 1 and 2 above were in conformance with regulations and rules therefore as required in the current manual of survey instructions of the United States Department of the Interior, Bureau of Land Management or by a decree of a Court of Law and/or that the corner points mentioned in lines 3, 4 and 5 above were in conformance with the rules of the Michigan Board of Land Surveyors or by a Decree of a Court of Law; established, re-established, monumented, re-monumented, recovered, found as expressed below:

	A	B	C	D	E	F	G	H	I	J	K	L
2	6	5	4	3	2	1						
3												
4	7	8	9	10	11	12						
5												
6	18	17	16	15	14	13						
7												
8	19	20	21	22	23	24						
9												
10	30	29	28	27	26	25						
11												
12	31	32	33	34	35	36						
13												

**NOTE: Not more than 4 corners, all in the same town and range, may be recorded on this certificate.**

**A. Description of original monument and accessories and/or subsequent restoration:**

1821 G.L.O. Notes  
 Joseph Wampler, D. S.  
 Cor. Sec. 1 & 12 a birch  
 14 inches diam. cor. tree.  
 - no accessories -

May 24, 1971 Witness card by K. D. Dunton with Rowe Engineering Inc. Found 1" pipe 12" deep. Set "T" inside pipe to raise cor. to surface pave. SE cor. Sec. 1, Arbela Twp. S70°E 114.85' NW cor. gar. @ #8015 Vassar S25°E 66.41' nail & cap in 24" tree. N25°E 142.87' nail & cap in p.p. N25°W 101.03' nail & cap in p.p. N15°E 150' rd. sign post. North 176.88' "T" at SW cor. Sec. 6, Millington

**B. Description of corner evidence found and/or method applied in restoring or reestablishing corner:**

Found "T" iron in mon. box and accepted as the proper position of the original corner. S20°W 179.43' nail & cap in t.


**C. Description of monument for corner and accessories established to perpetuate locating the position of the corner:**

Removed "T" iron & found 1" pipe below. Placed 5/8" iron rod and standard brass cap stamped corner M-3, T10N-R7E, in pipe in mon. box. Encased rod and brass cap in concrete in mon. box.  
 N42°45'W 48.97' fnd. 3/4" pipe in concrete.  
 N46°23'W 101.09' set T. C. Remon. tag & spike in E. face p. pole.  
 N23°08'E 142.85' set T. C. Remon. tag & spike in W. face p. pole.  
 S72°13'E 114.78' NW cor. garage at Hs. #8015 Vassar Rd.  
 S31°14'E 66.32' set T. C. Remon. tag & spike in W. root of 26" maple.  
 N00°33'20"W 176.90' fnd. "T" iron in mon. box at apparent cor. A-3, T10N-R7E

Signed by [Signature]  
 Surveyor's Michigan License No. 23503

Date November 21, 1994

**APPROVED**  
11-21-94  
 [Signatures]

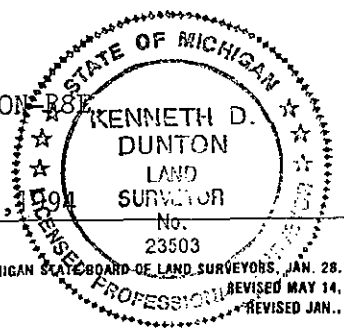

Section A continued:

April 11, 1973 Land Cor. Rec. form filed by David T. Rowe, L.S. #11192, on Page 28, Arbela Township. Found 1" pipe 12" deep. Set "T" iron inside pipe to raise corner to surface pavement.

S25°E 66.41' nail & cap in 24" tree.

N25°E 142.87' nail & cap in p.p.

N25°W 101.03' nail & cap in p.p.

March 3, 1980 Survey by Jan S. Fokens, L. S. #21567, with Rowe Engineering Inc., recorded in Liber 505 on Page 698, Tuscola County records. Fnd. "T"

S70°E 114.85' NW cor. gar. @ 8015 Vassar Rd.

S25°E 66.41' nail & cap in 24" tree.

N25°E 142.87' nail & cap in p.p.

